

NEWTON
 G 2005
 3-17-76

MISSISSIPPI
 BOARD OF WATER COMMISSIONERS
 416 North State Street
 13P Jackson, Mississippi 39201

WATER WELL DRILLERS LOG


5-17-76 19 McDONALD + HILL NEWTON
 date well completed firm name county well located

LANDOWNER:	description of formations encountered	from	to
<u>MAMIE GOODMAN</u>			
<u>Rt # 3 DECATUR</u> (mailing address)	<u>Sand</u>	<u>18</u>	<u>90</u>
WELL LOCATION: sec. <u>10</u> T. <u>7</u> N. R. <u>12</u> E. <u>3 1/2</u> miles <u>NEAST</u> of <u>DECATUR</u> (distance) (direction) (nearest town)	<u>Sand</u>	<u>98</u>	<u>128</u>
WELL PURPOSE: <u>HOME</u> (home, irrigation, municipal, industrial)	<u>Shale</u>	<u>128</u>	<u>145</u>
WELL COMPLETION DATA: (1) diameter (inches) <u>4"</u>	<u>Road</u>	<u>145</u>	<u>165</u>
(2) total depth (feet) <u>220'</u>	<u>Sand</u>	<u>165</u>	<u>220</u>
(3) static water level (feet) <u>108'</u> below top of ground.			
(4) casing <u>PVC</u> <u>140'</u> (material) (depth)			
<u>4"</u> if telescope see back. (size)			
(5) screen _____ (length) (depth to top)			
(size) _____ (material)			
(6) pump <u>1/2 sub 10</u> (HP) (yield gpm)			
<u>E</u> (type power)			
(7) electric log _____ (yes or no)			
(organization running log)			
(8) how well bottom plugged <u>OPEN</u>			
DRILLERS REMARKS: <u>SET PUMP 140'</u>			

REGISTERED
 MAR 19 1976

If well telescopes please sketch and show depths.

GROUND LEVEL

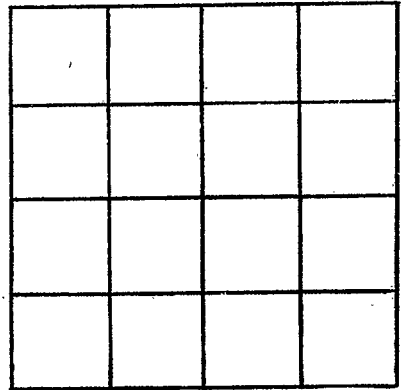

SECTION _____

Please indicate well location X.

ADDITIONAL INFORMATION

If more than one screen,
show locations of each on sketch.