

Newton  
G 2006  
8-3-76

MISSISSIPPI  
 BOARD OF WATER COMMISSIONERS  
 416 North State Street  
 Jackson, Mississippi 39201

WATER WELL DRILLERS LOG

8-3 1976 H. L. Strick Newton  
 date well completed firm name county well located

LANDOWNER: Sam Smith

description of formations encountered

from to

Decatur  
Miss  
 (mailing address)

Red Clay e 20  
Sandy Brown 20 39  
Blacks 39 68  
Blue sandy 68 120  
B. Sandy 120 130

WELL LOCATION:

sec. 17 T. 7N R. 12E  
1 miles NE of Decatur  
 (distance) (direction) (nearest town)

WELL PURPOSE: Home  
 (home, irrigation, municipal, industrial)

WELL COMPLETION DATA:

(1) diameter (inches) 7 11  
 (2) total depth (feet) 130  
 (3) static water level (feet) 76 below above top of ground.  
 (4) casing PVC, 77  
 (material) (depth)

\_\_\_\_\_ if telescope see back.  
 (size)

(5) screen Open Hole  
 (length) (depth to top)  
 \_\_\_\_\_  
 (size) (material)  
 (6) pump 1 350 PH  
 (HP) (yield gpm)  
Open  
 (type power)

(7) electric log \_\_\_\_\_  
 (yes or no)  
 \_\_\_\_\_  
 (organization running log)


(8) how well bottom plugged \_\_\_\_\_

DRILLERS REMARKS:

**RECEIVED**  
 SEP 3 1976  
 MISS. BD. OF WATER COMMISSIONERS

If well telescopes please sketch and show depths.

GROUND LEVEL

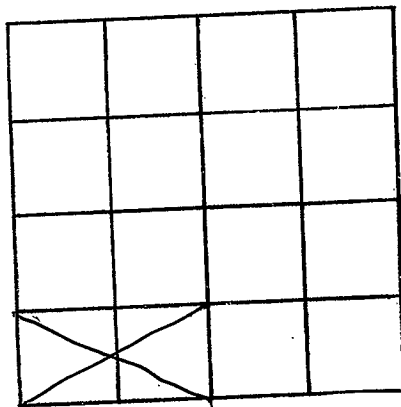

SECTION \_\_\_\_\_

Please indicate well location X.

ADDITIONAL INFORMATION

If more than one screen,  
show locations of each on sketch.