

Newton
G 2007
8/13/76

MISSISSIPPI
BOARD OF WATER COMMISSIONERS
416 North State Street
Jackson, Mississippi 39201

WATER WELL DRILLERS LOG

8.13.76 date well completed 13P McDonald + Hill firm name NEWTON county well located

LANDOWNER:
J. H. PAGE
R.H. DECATUR (mailing address)
WELL LOCATION:
sec. 21 T. 7 N. R. 15 E S
3 miles EAST DECATUR (distance) (direction) (nearest town)


description of formations encountered	from	to
Clay	0	6
Sand Clay	6	63
Shale	63	80
Shale	80	108
Black Sh. shale	108	120

WELL PURPOSE:
(home, irrigation, municipal, industrial) HOME

Brown sand	120	140
------------	-----	-----

WELL COMPLETION DATA:
(1) diameter (inches) 4"
(2) total depth (feet) 180'
(3) static water level (feet) 66' below top of ground.
(4) casing PVC, 100' (material) (depth)
4" (size) If telescope see back.
(5) screen (length) (depth to top)
(size) (material)
(6) pump 3/4 Sub 10 (HP) (yield gpm)
E (type power)
(7) electric log (yes or no)
(organization running log)
(8) how well bottom plugged OPEN

Sand	140	180
------	-----	-----

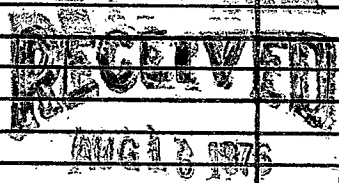


MISS. BLD. OF WATER COMM.

DRILLERS REMARKS:

If well telescopes please sketch and show depths.

GROUND LEVEL

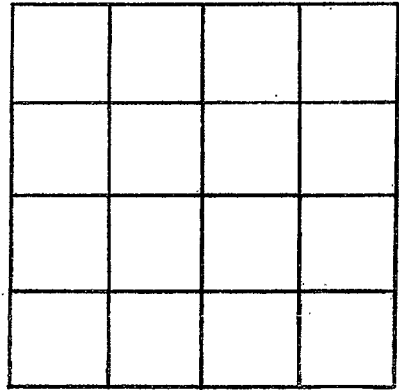

SECTION _____

Please indicate well location X.

ADDITIONAL INFORMATION

If more than one screen,
show locations of each on sketch.