

NEWTON
G 2008
9-20-76

MISSISSIPPI
 BOARD OF WATER COMMISSIONERS
 416 North State Street
 Jackson, Mississippi 39201

WATER WELL DRILLERS LOG

9.20.76 ^{13P} McDONALD + Hill NEWTON
 date well completed firm name county well located

LANDOWNER:
ERMA WANSLEY
R#1 DECATUR
 (mailing address)

WELL LOCATION:
 sec 33 T 7N R 12E
2 1/2 miles SEAST of DECATUR
 (distance) (direction) (nearest town)

WELL PURPOSE: 1-6000
 (home, irrigation, municipal, industrial)

- WELL COMPLETION DATA:
- (1) diameter (inches) 4"
 - (2) total depth (feet) 250'
 - (3) static water level (feet) 70' below top of ground.
 - (4) casing pvc 100'
 (material) (depth)
4"
 (size) if telescope see back.
 - (5) screen _____
 (length) (depth to top)

 (size) (material)
 - (6) pump 1/2 508 10
 (HP) (yield gpm)
E
 (type power)
 - (7) electric log _____
 (yes or no)

 (organization running log)
 - (8) how well bottom plugged OPEN

| description of formations encountered | from | to |
|---------------------------------------|------------|------------|
| <u>Clay</u> | <u>0</u> | <u>14</u> |
| <u>Shale</u> | <u>14</u> | <u>26</u> |
| <u>Sand</u> | <u>26</u> | <u>75</u> |
| <u>Shale</u> | <u>75</u> | <u>105</u> |
| <u>Rock</u> | <u>105</u> | <u>120</u> |
| <u>Sand</u> | <u>120</u> | <u>134</u> |
| <u>Rock to shell</u> | <u>134</u> | <u>150</u> |
| <u>Rock Shale</u> | <u>150</u> | <u>230</u> |
| <u>hardly to bed</u> | <u>230</u> | <u>250</u> |

RECEIVED


SEP 24 1976

MISS. BD. OF WATER COMMISSIONERS

DRILLERS REMARKS: _____

If well telescopes please sketch and show depths.

GROUND LEVEL

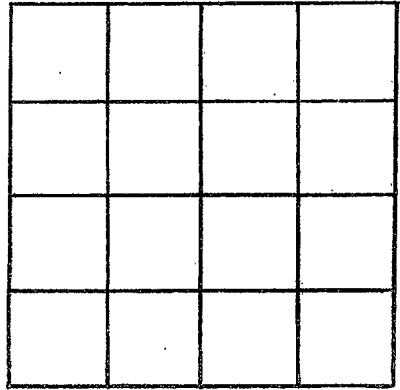

SECTION _____

Please indicate well location X.

ADDITIONAL INFORMATION

If more than one screen,
show locations of each on sketch.