

Newton  
G 2009  
11-5-76

MISSISSIPPI  
 BOARD OF WATER COMMISSIONERS  
 416 North State Street  
 Jackson, Mississippi 39201

WATER WELL DRILLERS LOG

11-5-76 19 William Drilling Newton  
 date well completed firm name county well located


LANDOWNER: <u>R. J. Harris</u>	description of formations encountered	from	to
<u>112 Raf 191</u>			
<u>Deatur</u> (mailing address)	<u>red clay</u>	<u>0</u>	<u>7</u>
	<u>Blue clay</u>	<u>9</u>	<u>60</u>
	<u>sand</u>	<u>60</u>	<u>135</u>
	<u>Blue clay + rock</u>	<u>135</u>	<u>202</u>
	<u>sand</u>	<u>202</u>	<u>242</u>
WELL LOCATION: sec <u>17</u> T <u>70N</u> R <u>12E</u> S W			
<u>1</u> miles <u>E</u> of <u>Deatur</u> (distance) (direction) (nearest town)			
WELL PURPOSE: <u>Home</u> (home, irrigation, municipal, industrial)			
WELL COMPLETION DATA:			
(1) diameter (inches) <u>4</u>			
(2) total depth (feet) <u>242</u>			
(3) static water level (feet) <u>110</u> <u>below</u> top of ground.			
(4) casing <u>PVC</u> , <u>146</u> , (material) (depth)			
<u>4</u> if telescope see back. (size)			
(5) screen <u>no</u> , (length) (depth to top)			
(size) (material)			
(6) pump <u>1/2</u> <u>10</u> (HP) (yield gpm)			
<u>Electric</u> (type power)			
(7) electric log <u>no</u> (yes or no)			
<u>no</u> (organization running log)			
(8) how well bottom plugged <u>open</u>			
DRILLERS REMARKS:			

RECEIVED  
 MAR - 8 1977

MISS. BD. OF WATER COMMISSIONERS

If well telescopes please sketch and show depths.

GROUND LEVEL

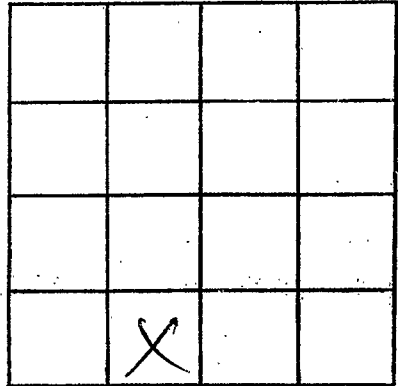

SECTION 17

Please indicate well location X.

ADDITIONAL INFORMATION

If more than one screen, show locations of each on sketch.