

NEWTON
G 2010
8/5/76

MISSISSIPPI
 BOARD OF WATER COMMISSIONERS
 416 North State Street
 Jackson, Mississippi 39201

WATER WELL DRILLERS LOG

8.5.76 19 McDONALD & HILL NEWTON
 date well completed firm name county well located

LANDOWNER:
OMER ROWZEE
R#2 DECATUR MISS
 (mailing address)

description of formations encountered	from	to
<u>Clay</u>	<u>0</u>	<u>16</u>
<u>Sand</u>	<u>16</u>	<u>35</u>
<u>Shale & Rock</u>	<u>35</u>	<u>90</u>
<u>Sand</u>	<u>90</u>	<u>125</u>

WELL LOCATION:
 sec. 26 T. 7 (N) R. 12 (E)
5 miles SOUTH of DECATUR
 (distance) (direction) (nearest town)

description of formations encountered	from	to
<u>Clay</u>	<u>0</u>	<u>16</u>
<u>Sand</u>	<u>16</u>	<u>35</u>
<u>Shale & Rock</u>	<u>35</u>	<u>90</u>
<u>Sand</u>	<u>90</u>	<u>125</u>

WELL PURPOSE: Home
 ((home) irrigation, municipal, industrial)

- WELL COMPLETION DATA:
- (1) diameter (inches) 2"
 - (2) total depth (feet) 125'
 - (3) static water level (feet) 90' below above top of ground.
 - (4) casing Galv, 118'
 (material) (depth)
2" if telescope see back.
 (size)
 - (5) screen 5', 120'
 (length) (depth to top)
2", plc
 (size) (material)
 - (6) pump 1/2 Rod, 3
 (HP) (yield gpm)
E
 (type power)
 - (7) electric log —
 (yes or no)
 (organization running log)
 - (8) how well bottom plugged VALVE


RECEIVED
 AUG 9 - 1976

DRILLERS REMARKS:

MISS. BD. OF WATER COMMISSIONERS

If well telescopes please sketch and show depths.

GROUND LEVEL

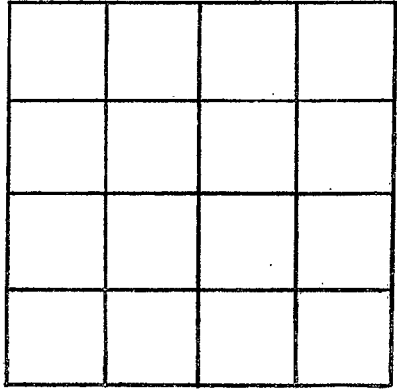

SECTION _____

Please indicate well location X.

ADDITIONAL INFORMATION

If more than one screen,
show locations of each on sketch.