

NEWTON
 G 2011
 11-19-76

MISSISSIPPI
 BOARD OF WATER COMMISSIONERS
 416 North State Street
 Jackson, Mississippi 39201

WATER WELL DRILLERS LOG

11-19 date well completed
 13P 1976 Common Drilling Service firm name
 Newton county well located

LANDOWNER: Billy Skelton
Debra R. Skelton

description of formations encountered	from	to
Red Sand	0	30
Clay	30	90
Sand	90	120
Clay + Rock	120	220
Very Hard Ledges		
Sand Very Good	220	240

(mailing address)

WELL LOCATION:
 sec. 23 T 5 N R. 12 E
3 miles Se of Newton
 (distance) (direction) (nearest town)

WELL PURPOSE: Home
 (home, irrigation, municipal, industrial)

WELL COMPLETION DATA:

- (1) diameter (inches) 5"
- (2) total depth (feet) 240
- (3) static water level (feet) 105 below top of ground.
- (4) casing Steel 140
 (material) (depth)
 (size) if telescope see back.
- (5) screen None
 (length) (depth to top)
 (size) (material)
- (6) pump 1 4
 (HP) (yield gpm)
F
 (type power)
- (7) electric log NO
 (yes or no)
- (organization running log)
- (8) how well bottom plugged


DRILLERS REMARKS: Open Bottom

RECEIVED
 MAY 5 - 1977

MISS. BD. OF WATER COMMISSIONERS

If well telescopes please sketch and show depths.

GROUND LEVEL

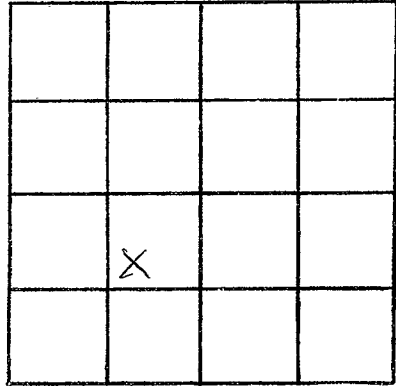

SECTION 23

Please indicate well location X.

ADDITIONAL INFORMATION

If more than one screen,
show locations of each on sketch.