

Newton  
G 2012  
12/29/76

MISSISSIPPI  
 BOARD OF WATER COMMISSIONERS  
 416 North State Street  
 Jackson, Mississippi 39201

WATER WELL DRILLERS LOG

12-29-76 <sup>13P</sup> McDonald + Kel Newton  
 date well completed firm name county well located

LANDOWNER:  
Clarence Blount  
Rt # 2 Decatur  
 (mailing address)

description of formations encountered	from	to
<u>clay</u>	<u>0</u>	<u>10</u>
<u>sand</u>	<u>10</u>	<u>50</u>
<u>shale</u>	<u>50</u>	<u>94</u>
<u>Rock + shell</u>	<u>94</u>	<u>115</u>
<u>sand + st rock</u>	<u>115</u>	<u>125</u>

WELL LOCATION:  
2 sec. 26 T 7 N R. 12 E  
0 X 3 miles East of Decatur  
 (distance) (direction) (nearest town)

WELL PURPOSE: Home  
 (home, irrigation, municipal, industrial)

<u>shale st shells</u>	<u>125</u>	<u>140</u>
<u>sand st rock</u>	<u>140</u>	<u>160</u>
<u>shale st sand</u>	<u>160</u>	<u>200</u>

- WELL COMPLETION DATA:
- (1) diameter (inches) 4"
  - (2) total depth (feet) 200'
  - (3) static water level (feet) 92 below above top of ground.
  - (4) casing PVC 90'  
 (material) (depth)  
4"  
 (size) If telescope see back.
  - (5) screen —  
 (length) (depth to top)  
—  
 (size) (material)
  - (6) pump 1/2 5gpm  
 (HP) (yield gpm)  
sub  
 (type power)
  - (7) electric log —  
 (yes or no)  
 (organization running log)
  - (8) how well bottom plugged open


**RECEIVED**

JAN 3 1977

DRILLERS REMARKS:

If well telescopes please sketch and show depths.

GROUND LEVEL

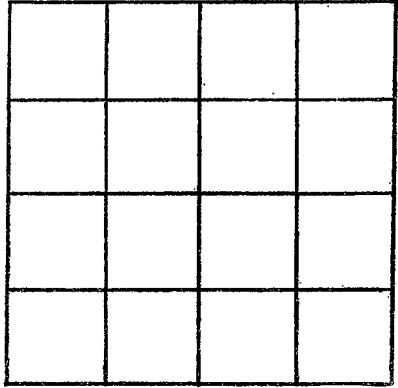

SECTION \_\_\_\_\_

Please indicate well location X.

ADDITIONAL INFORMATION

If more than one screen, show locations of each on sketch.