

Newton
G 2013
12/30/76

MISSISSIPPI
 BOARD OF WATER COMMISSIONERS
 416 North State Street
 13P Jackson, Mississippi 39201

WATER WELL DRILLERS LOG

12-30-76 date well completed McDonald + Hill firm name Newton county well located

LANDOWNER:
Auburn Majors
Rt # 2 Decatur
 (mailing address)

WELL LOCATION:
 sec. 21 T. 7 N. R. 12 E.
3 miles S East of Decatur
 (distance) (direction) (nearest town)

WELL PURPOSE: Home
 (home, irrigation, municipal, industrial)

- WELL COMPLETION DATA:
- (1) diameter (inches) 4"
 - (2) total depth (feet) 200'
 - (3) static water level (feet) 80' below top of ground.
 - (4) casing PVC, 130'
 (material) (depth)
4" if telescope see back.
 (size)
 - (5) screen _____
 (length) (depth to top)

 (size) (material)
 - (6) pump 1/2 50 GPM
 (HP) (yield gpm)
out
 (type power)
 - (7) electric log _____
 (yes or no)

 (organization running log)
 - (8) how well bottom plugged open


description of formations encountered	from	to
<u>clay + sand</u>	<u>0</u>	<u>85</u>
<u>shale</u>	<u>85</u>	<u>135</u>
<u>Rock + shells</u>	<u>135</u>	<u>152</u>
<u>sand + rock</u>	<u>152</u>	<u>165</u>
<u>sand</u>	<u>165</u>	<u>200</u>

RECEIVED
 JAN 10 1977
 MISSISSIPPI BOARD OF WATER COMMISSIONERS

DRILLERS REMARKS:

If well telescopes please sketch and show depths.

GROUND LEVEL

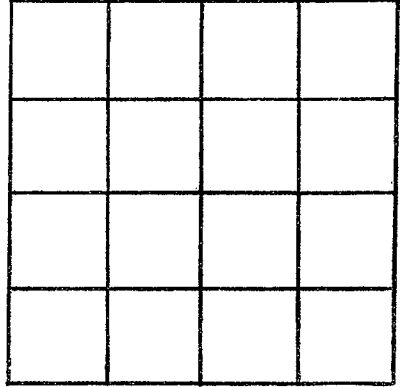

SECTION _____

Please indicate well location X.

ADDITIONAL INFORMATION

If more than one screen,
show locations of each on sketch.