

NEWTON
G 205
5-19-77

MISSISSIPPI
 BOARD OF WATER COMMISSIONERS
 416 North State Street
 Jackson, Mississippi 39201

WATER WELL DRILLERS LOG

5-19-77 19 McDonald & Hill Newton
 date well completed firm name county well located

LANDOWNER:
Danny Heflin
Rt #2 Decatur
 (mailing address)

WELL LOCATION:
 sec. 26 T. 7 N. R. 12 E
8 miles SE of Decatur
 (distance) (direction) (nearest town)

WELL PURPOSE: home
 (home, irrigation, municipal, industrial)

WELL COMPLETION DATA:

- (1) diameter (inches) 4"
- (2) total depth (feet) 150'
- (3) static water level (feet) 100' below top of ground.
- (4) casing PVC, 80'
 (material) (depth)
4" if telescope see back.
 (size)
- (5) screen _____
 (length) (depth to top)

 (size) (material)
- (6) pump 1/2 59 gpm
 (HP) (yield gpm)
E
 (type power)
- (7) electric log _____
 (yes or no)

 (organization running log)
- (8) how well bottom plugged open


description of formations encountered	from	to
<u>sand + clay</u>	<u>0</u>	<u>40</u>
<u>sandy shale</u>	<u>40</u>	<u>65</u>
<u>shale</u>	<u>65</u>	<u>85</u>
<u>rock + shells</u>	<u>85</u>	<u>105</u>
<u>green sand</u>	<u>108</u>	<u>115</u>
<u>shale</u>	<u>115</u>	<u>125</u>
<u>sand</u>	<u>125</u>	<u>150</u>

RECEIVED
 MAY 23 1977
 MISSISSIPPI BOARD OF WATER COMMISSIONERS

DRILLERS REMARKS:

If well telescopes please
sketch and show depths.

GROUND LEVEL

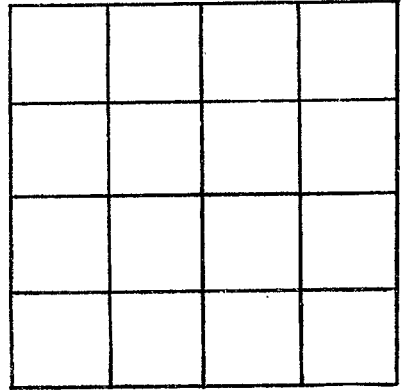

SECTION _____

Please indicate well location X.

ADDITIONAL INFORMATION

If more than one screen,
show locations of each on sketch.