

Newton  
 5 2017  
 12/30/77

MISSISSIPPI  
 BOARD OF WATER COMMISSIONERS  
 416 North State Street  
 Jackson, Mississippi 39201

WATER WELL DRILLERS LOG

12-30-77 19 McDonald & Hill Newton  
 date well completed firm name county well located

LANDOWNER:  
 Paul Manoly  
 Decatur  
 (mailing address)

WELL LOCATION:  
 sec. 29 T-1 N S R-12 E  
 2 miles S of Decatur  
 (distance) (direction) (nearest town)

WELL PURPOSE:  
 (home, irrigation, municipal, industrial)

- WELL COMPLETION DATA:
- (1) diameter (inches) 4"
  - (2) total depth (feet) 260'
  - (3) static water level (feet) 9.5' below top of ground.
  - (4) casing PVC 127' (material) (depth)  
 4" (size) if telescope see back.
  - (5) screen (length) (depth to top)  
 (size) (material)
  - (6) pump 1/2 400W (HP) (yield gpm)  
 E (type power)
  - (7) electric log (yes or no)  
 (organization running log)
  - (8) how well bottom plugged Open

description of formations encountered	from	to
clay & sand	0	20
sand & st clay	20	70
sand & st shale	70	100
shale	100	130
Rock & shells	130	163
green sand & cherty shale	153	165
Rock & shale & sandy shale	165	260


RECEIVED  
 JAN - 9 1978

DRILLERS REMARKS:

MISS. BD. OF WATER

If well telescopes please sketch and show depths.

GROUND LEVEL

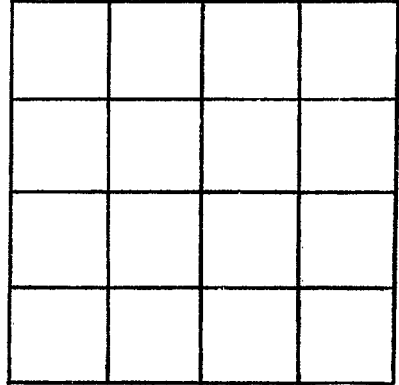

SECTION \_\_\_\_\_

Please indicate well location X.

ADDITIONAL INFORMATION

If more than one screen,  
show locations of each on sketch.