

Newton
 5 2018
 11/17/77

MISSISSIPPI
 BOARD OF WATER COMMISSIONERS
 416 North State Street
 Jackson, Mississippi 39201

WATER WELL DRILLERS LOG

11-17-77 date well completed
 McDonald & Hill firm name
 Newton county well located

LANDOWNER:
 Gerald Meadows
 Rt #2 Deatur
 (mailing address)

description of formations encountered	from	to
clay	0	12
sand	12	40
shale	40	70
Rock & shell	70	88
green sand	88	100
Rock & shale	100	107
sand	107	120

WELL LOCATION:
 sec. 17 T 7 N R 12 E
 S W
 0 miles NW of Deatur
 (distance) (direction) (nearest town)

WELL PURPOSE: home
 (home, irrigation, municipal, industrial)

- WELL COMPLETION DATA:
- (1) diameter (inches) 4"
 - (2) total depth (feet) 120'
 - (3) static water level (feet) 40' below top of ground.
 - (4) casing PVC 66' (material) (depth)
 4" (size) if telescope see back.
 - (5) screen (length) (depth to top)
 (size) (material)
 - (6) pump 1/2 HP 69 gpm (HP) (yield gpm)
 (type power)
 - (7) electric log (yes or no)
 (organization running log)
 - (8) how well bottom plugged open

DRILLERS REMARKS:


RECEIVED

NOV 30 1977

MISS. BD. OF WATER COMM.

If well telescopes please sketch and show depths.

GROUND LEVEL

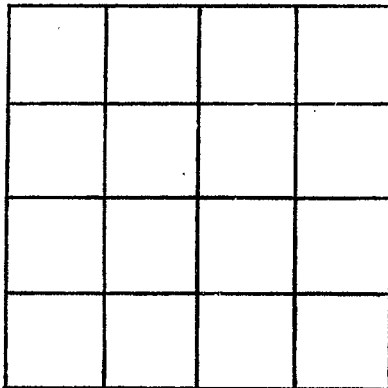

SECTION _____

Please indicate well location X.

ADDITIONAL INFORMATION

If more than one screen, show locations of each on sketch.