

NEWTON

G 200

8-18-78

MISSISSIPPI
BOARD OF WATER COMMISSIONERS
416 North State Street
Jackson, Mississippi 39201

WATER WELL DRILLERS LOG

8-18-78 19 McDonald & Hill Newton
date well completed firm name county well located

LANDOWNER:

Jackie Fulton

Deater

(mailing address)

description of formations encountered

from

to

clay + sand

0

20

sand

20

45

WELL LOCATION:

sec. 7 T 7 N R 10 E
W

0 miles N of Deater
(distance) (direction) (nearest town)

WELL PURPOSE: home
(home, irrigation, municipal, industrial)

WELL COMPLETION DATA:

- (1) diameter (inches) 2"
- (2) total depth (feet) 45'
- (3) static water level (feet) 28" below above top of ground.

- (4) casing PVC 40'
(material) (depth)
2" if telescope see back.
(size)

- (5) screen 5' 40' to 45'
(length) (depth to top)
2" PVC
(size) (material)

- (6) pump 1/2 490m
(HP) (yield gpm)
E
(type power)

- (7) electric log (yes or no)

(organization running log)

- (8) how well bottom plugged 1/2 value


DRILLERS REMARKS:

RECEIVED
AUG 29 1978

MISS. BD. OF WATER COMM.

If well telescopes please sketch and show depths.

GROUND LEVEL

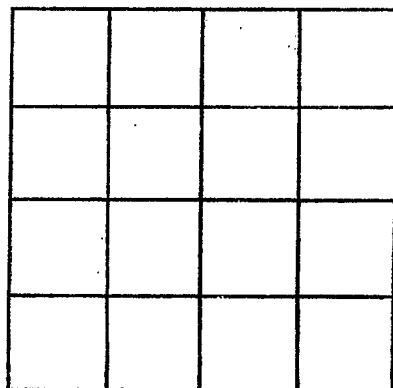

SECTION _____

Please indicate well location X.

ADDITIONAL INFORMATION

If more than one screen, show locations of each on sketch.