

NEWTON
G 2021
04-05-79

MISSISSIPPI
BOARD OF WATER COMMISSIONERS
416 North State Street
Jackson, Mississippi 39201

WATER WELL DRILLERS LOG

4-5-79 19 McDonald & Hill Newton
date well completed firm name county well located

LANDOWNER:	description of formations encountered	from	to
Jessie Sawell	clay & sand	0	16
Rt # 2 Decatur (mailing address)	sand	16	45
WELL LOCATION: sec 6 T 7 N R 12 E 3 miles N of Decatur (distance) (direction) (nearest town)	sandy shale	45	60
	shale	60	85
	Rock & shells	85	102
WELL PURPOSE: home (home, irrigation, municipal, industrial)	orange sand & sandy shale	102	113
WELL COMPLETION DATA:			
(1) diameter (inches) 4"	shale & Rock	113	130
(2) total depth (feet) 145'	sand	130	145
(3) static water level (feet) 60' below top of ground.			
(4) casing PVC 82' (material) (depth) 4" if telescope see back. (size)			
(5) screen (length) (depth to top) (size) (material)			
(6) pump 1/2 (HP) 600 (yield gpm) E (type power)			
(7) electric log (yes or no) (organization running log)			
(8) how well bottom plugged Open			

DRILLERS REMARKS:


Miss. Board of Water Comm.

APR 11 1979

RECEIVED

If well telescopes please sketch and show depths.

GROUND LEVEL

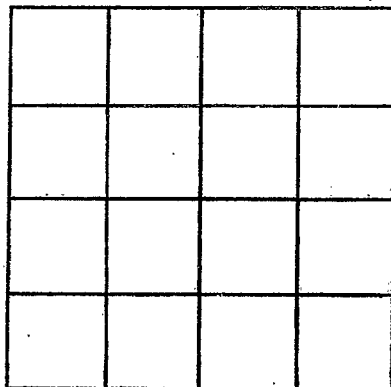

SECTION _____

Please indicate well location X.

ADDITIONAL INFORMATION

If more than one screen,
show locations of each on sketch.