

NEWTON
G 2022
6-12-79

MISSISSIPPI
 BOARD OF WATER COMMISSIONERS
 416 North State Street
 Jackson, Mississippi 39201

WATER WELL DRILLERS LOG

Newton

6-12-79
 date well completed

McDonald & Hill
 firm name

county well located

LANDOWNER:	description of formations encountered	from	to
<u>Harry Mathis</u>			
<u>RT # 1 Decatur</u> (mailing address)	<u>sandy shale</u>	<u>80</u>	<u>90</u>
WELL LOCATION: sec. <u>32</u> T <u>7</u> N S <u>12</u> E W <u>2</u>	<u>shale</u>	<u>90</u>	<u>131</u>
<u>2</u> miles <u>SE</u> of <u>Decatur</u>	<u>Rock & shale</u>	<u>131</u>	<u>155</u>
(distance) (direction) (nearest town)	<u>green sand & sandy shale</u>	<u>155</u>	<u>165</u>
WELL PURPOSE: <u>home</u> (home, irrigation, municipal, industrial)	<u>shale & rock & sand</u>	<u>165</u>	<u>210</u>
WELL COMPLETION DATA:			
(1) diameter (inches) <u>4"</u>			
(2) total depth (feet) <u>210'</u>			
(3) static water level (feet) <u>70'</u> below top of ground.			
(4) casing <u>PVC</u> , <u>125'</u> (material) (depth)			
<u>4"</u> (size) if telescope see back.			
(5) screen _____ (length) (depth to top)			
_____ (size) _____ (material)			
(6) pump <u>3/4</u> <u>85 gpm</u> (HP) (yield gpm)			
<u>F</u> (type power)			
(7) electric log _____ (yes or no)			
_____ (organization running log)			
(8) how well bottom plugged <u>open</u>			
DRILLERS REMARKS:			


Miss. Board of Water Comm.

JUN 18 1979

RECEIVED

If well telescopes please sketch and show depths.

GROUND LEVEL

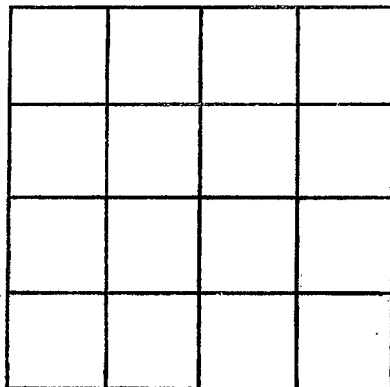

SECTION _____

Please indicate well location X.

ADDITIONAL INFORMATION

If more than one screen,
show locations of each on sketch.