

Newton  
G 2023  
5-13-80

MISSISSIPPI  
BOARD OF WATER COMMISSIONERS  
416 North State Street  
Jackson, Mississippi 39201

WATER WELL DRILLERS LOG

4-25-80 19 McDonald & Hill Newton  
date well completed firm name county well located

LANDOWNER:	description of formations encountered	from	to
John Sandefor	cls.	0	15
Rt # 2 Box 67, Decatur (mailing address)	sand	15	50
WELL LOCATION:	sandy shale	50	70
sec. 27 T. 7 N. R. 12 E. 6 miles SE of Decatur (distance) (direction) (nearest town)	shale	70	100
WELL PURPOSE: home (home, irrigation, municipal, industrial)	rock & shells	100	120
WELL COMPLETION DATA:	green sand & sandy shale	120	130
(1) diameter (inches) 4"	sand & shale	130	200
(2) total depth (feet) 200			
(3) static water level (feet) 100' below top of ground.			
(4) casing PVC 95' (material) (depth) 4" (size) If telescope see back.			
(5) screen (length) (depth to top) (size)			
(6) pump 1 (HP) 60 gpm (material) (yield gpm) K (type power)			
(7) electric log (yes or no) (organization running log)			
(8) how well bottom plugged			
DRILLERS REMARKS:			


DEPT. OF NATURAL RESOURCES  
BUREAU OF LAND & WATER RESOURCES

MAY 7 - 1980

RECEIVED

If well telescopes please sketch and show depths.

GROUND LEVEL

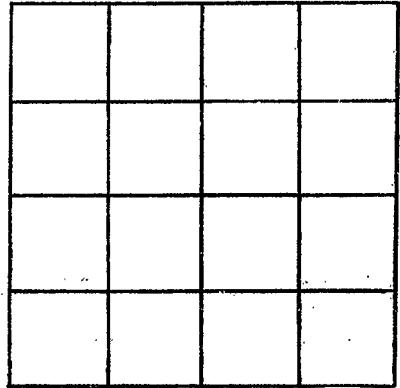

SECTION \_\_\_\_\_

Please indicate well location X.

ADDITIONAL INFORMATION

If more than one screen, show locations of each on sketch.