

NEWTON
G 2024
11-19-80

MISSISSIPPI
 BOARD OF WATER COMMISSIONERS
 416 North State Street
 Jackson, Mississippi 39201

WATER WELL DRILLERS LOG

11-19-80 19 McDonald & Hill Newton
 date well completed firm name county well located


LANDOWNER:	description of formations encountered	from	to
<u>Avery Addy</u>	<u>sand & clay</u>	<u>0</u>	<u>25</u>
<u>Deaton</u> (mailing address)	<u>sandy shale</u>	<u>25</u>	<u>40</u>
WELL LOCATION:	<u>shale</u>	<u>40</u>	<u>105</u>
sec <u>7</u> T <u>7</u> N <u>5</u> R <u>12</u> E <u>W</u>	<u>Rock & shells</u>	<u>65</u>	<u>85</u>
<u>2</u> miles <u>N</u> of <u>Deaton</u>	<u>green sand & sandy shale</u>	<u>85</u>	<u>95</u>
(distance) (direction) (nearest town)	<u>Rock & shale</u>	<u>95</u>	<u>105</u>
WELL PURPOSE: <u>home</u> (home, irrigation, municipal, industrial)	<u>sand</u>	<u>105</u>	<u>113</u>
WELL COMPLETION DATA:	<u>Rock & shale</u>	<u>115</u>	<u>230</u>
(1) diameter (inches) <u>4"</u>	<u>shale & sand</u>	<u>230</u>	<u>217</u>
(2) total depth (feet) <u>260'</u>	<u>sand</u>	<u>240</u>	<u>260</u>
(3) static water level (feet) <u>65'</u> below above top of ground.			
(4) casing <u>PVC 1 1/2"</u> (material) <u>162'</u> (depth)			
<u>4"</u> (size) if telescope see back.			
(5) screen (length) (depth to top)			
(size) (material)			
(6) pump <u>1/2</u> (HP) <u>89.0 m</u> (yield gpm)			
(type power)			
(7) electric log (yes or no)			
(organization running log)			
(8) how well bottom plugged <u>open</u>			
DRILLERS REMARKS:			

DEPT. OF NATURAL RESOURCES
 BUREAU OF LAND & WATER RESOURCES

NOV 25 1980
 RECEIVED

If well telescopes please sketch and show depths.

GROUND LEVEL

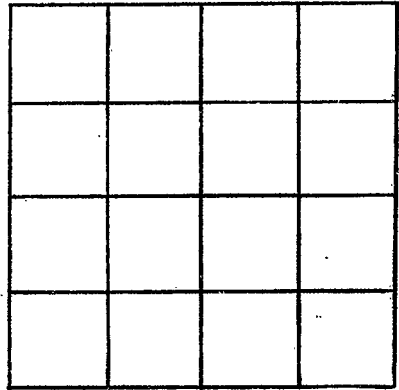

SECTION _____

Please indicate well location X.

ADDITIONAL INFORMATION

If more than one screen, show locations of each on sketch.