

MISSISSIPPI DEPARTMENT OF NATURAL RESOURCES

Bureau of Land and Water Resources

Southport Mall

P.O. Box 10631

Jackson, Mississippi 39209

WATER WELL DRILLERS LOG

Newton
G 2026
6/4/81
6-14-81


date well completed

firm name

county well located

McDonald & Hill Newton


LANDOWNER:	description of formations encountered	from	to
<u>Joe L. Johnson</u>	<u>clay + sand</u>	<u>0</u>	<u>25</u>
<u>Decatur</u> (mailing address)	<u>shale</u>	<u>25</u>	<u>55</u>
WELL LOCATION:	<u>Rock + shells</u>	<u>55</u>	<u>65</u>
sec. <u>14</u> T- <u>7</u> N R- <u>10</u> E	<u>Rock + clay</u>	<u>65</u>	<u>75</u>
<u>6</u> miles <u>E</u> of <u>Decatur</u>	<u>sand</u>	<u>75</u>	<u>110</u>
(distance) (direction) (nearest town)	<u>shale + rock</u>	<u>110</u>	<u>225</u>
WELL PURPOSE: <u>none</u> (home, irrigation, municipal, industrial)	<u>shale + st sand</u>	<u>225</u>	<u>240</u>
WELL COMPLETION DATA:	<u>sand + shale</u>	<u>240</u>	<u>265</u>
(1) diameter (inches) <u>4"</u>	<u>shale + fine sand</u>	<u>265</u>	<u>280</u>
(2) total depth (feet) <u>280'</u>			
(3) static water level (feet) <u>135'</u> below top of ground.			
(4) casing <u>PVC 215'</u> (material) (depth)			
<u>4</u> if telescope see back. (size)			
(5) screen _____ (length) (depth to top)			
(size) (material)			
(6) pump <u>3/4</u> <u>5000</u> (HP) (yrd/gpm)			
(type power) <u>E</u>			
(7) electric log _____ (yes or no)			
(organization running log)			
(8) how well bottom plugged <u>open</u>			

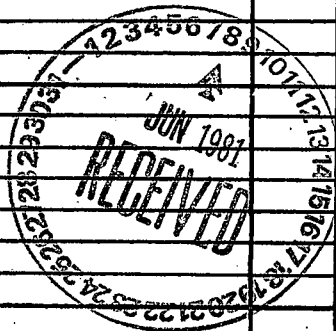

DRILLERS REMARKS:

If well telescopes please sketch and show depths.

GROUND LEVEL

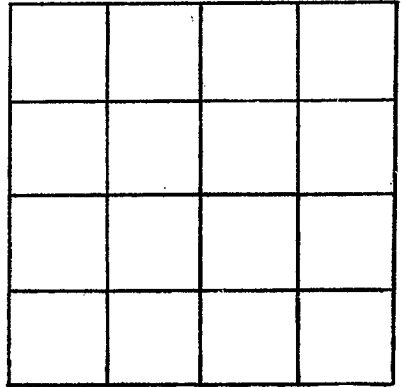

SECTION _____

Please indicate well location X.

ADDITIONAL INFORMATION

If more than one screen,
show locations of each on sketch.