

Newton
G.
2008

MISSISSIPPI
BOARD OF WATER COMMISSIONERS
416 North State Street
Jackson, Mississippi 39201

WATER WELL DRILLERS LOG

Jan 1982 date well completed
82 McDonald Hill firm name
Newton county well located

LANDOWNER: R.L. Dickinson
Newton, Miss
(mailing address)

WELL LOCATION:
sec. 31 T. 7 N R. 14 E
7 miles north of Newton
(distance) (direction) (nearest town)

WELL PURPOSE: home
(home, irrigation, municipal, industrial)

WELL COMPLETION DATA:
(1) diameter (inches) 4
(2) total depth (feet) 320
(3) static water level (feet) 110 below top of ground.
(4) casing 4" PVC 260' (material) (depth)
(size) if telescope see back.
(5) screen (length) (depth to top)
(size) (material)
(6) pump (HP) (yield gpm)
(type power)
(7) electric log (yes or no)
(organization running log)
(8) how well bottom plugged open

description of formations encountered	from	to
Clay	0	10
Shale sandy st	10	54
Sand	54	60
Shale	60	74
Sand	74	160
Sand st Brown shale	160	200
sandy	200	235
hard shale	235	270
sandy st Rock	270	295
Coarse green sand	295	315
Shale	315	320

DEPT. OF NATURAL RESOURCES
BUREAU OF LAND & WATER RESOURCES
JURCH


FEB - 1 1982
RECEIVED

DRILLERS REMARKS:

If well telescopes please sketch and show depths.

82 FEB 1 A 8:48

GROUND LEVEL

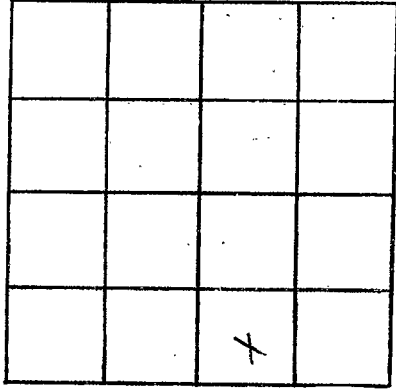

SECTION 31

Please indicate well location X.

ADDITIONAL INFORMATION

A series of horizontal lines for writing additional information, starting below the 'ADDITIONAL INFORMATION' header and extending to the bottom of the page.

If more than one screen, show locations of each on sketch.