

Newton  
G  
2029

MISSISSIPPI DEPARTMENT OF NATURAL RESOURCES  
Bureau of Land and Water Resources  
Southport Mall  
P.O. Box 10631  
Jackson, Mississippi 39209  
WATER WELL DRILLERS LOG

1-17-84  
date well completed

McDonald & Hill  
firm name


Newton  
county well located

LANDOWNER:	description of formations encountered	from	to
Mrs Jim Dault	clay	0	10
Rt #2 Box 263 Deatur (mailing address)	sand	10	80
WELL LOCATION:	sandy shale	80	90
sec. 7 T. 7 N R. 12 E (distance) (direction) (nearest town)	shale	90	118
3 miles N of Deatur	Rock & shales	118	140
WELL PURPOSE: <u>stone</u> (home, irrigation, municipal, industrial)	green sand	140	148
WELL COMPLETION DATA:	st Rock shales & sand	148	160
(1) diameter (inches) <u>4"</u>	sand	160	170
(2) total depth (feet) <u>170'</u>			
(3) static water level (feet) <u>90'</u> below above top of ground.			
(4) casing <u>PVC</u> (material) <u>114'</u> (depth)			
<u>4"</u> (size) If telescope see back.			
(5) screen (length) (depth to top)			
(size) (material)			
(6) pump <u>1/2</u> (HP) <u>59 gpm</u> (yield gpm)			
<u>F</u> (type power)			
(7) electric log (yes or no)			
(organization running log)			
(8) how well bottom plugged <u>open</u>			
DRILLERS REMARKS:			

RECEIVED  
JAN 23 1984  
BUREAU OF LAND & WATER RESOURCES  
DEPT. OF NATURAL RESOURCES

If well telescopes please  
sketch and show depths.

GROUND LEVEL

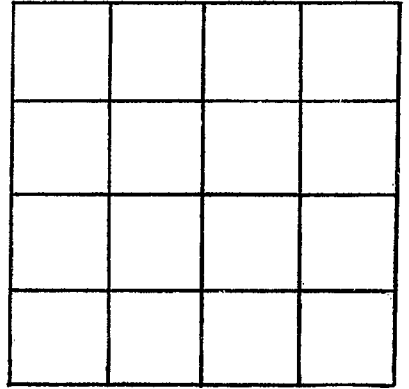

SECTION \_\_\_\_\_

Please indicate well location X.

ADDITIONAL INFORMATION

If more than one screen,  
show locations of each on sketch.