

MISSISSIPPI DEPARTMENT OF NATURAL RESOURCES

Bureau of Land and Water Resources

Southport Mall

P.O. Box 10631

Jackson, Mississippi 39209

WATER WELL DRILLERS LOG

Newton
G G
2030
1/61/84

date well completed

19

McDonald & Hill

firm name

Newton

county well located

LANDOWNER:	description of formations encountered	from	to
<u>T. E. Scoogins</u> <u>Rt #1 Newton</u> (mailing address)			
WELL LOCATION: sec. <u>31</u> T <u>7</u> N R <u>12</u> E S W <u>3</u> miles <u>S</u> of <u>Durata</u> (distance) (direction) (nearest town)	<u>shale</u>	<u>10</u>	<u>45</u>
WELL PURPOSE: <u>home</u> (home, irrigation, municipal, industrial)	<u>sand & shale</u>	<u>45</u>	<u>110</u>
WELL COMPLETION DATA:	<u>sandy shale</u>	<u>110</u>	<u>145</u>
(1) diameter (inches) <u>4x2</u>	<u>shale</u>	<u>145</u>	<u>180</u>
(2) total depth (feet) <u>255'</u>	<u>rock & shells</u>	<u>180</u>	<u>205</u>
(3) static water level (feet) <u>90</u> below top of ground.	<u>green sand</u>	<u>205</u>	<u>225</u>
(4) casing <u>PVC</u> <u>180'</u> (material) (depth) <u>4"</u> if telescope see back. <u>2" PVC</u> (size)			
(5) screen <u>10</u> <u>215 to 225</u> (length) (depth to top) <u>2"</u> <u>PVC</u> (size) (material)			
(6) pump <u>1/2</u> <u>59 gpm</u> (HP) (yield gpm) <u>K</u> (type power)			
(7) electric log <u>—</u> (yes or no) <u>—</u> (organization running log)			
(8) how well bottom plugged <u>value</u>			


DRILLERS REMARKS:

DEPT. OF NATURAL RESOURCES
 BUREAU OF LAND & WATER RESOURCES

JAN 23 1984
 RECEIVED

If well telescopes please sketch and show depths.

GROUND LEVEL

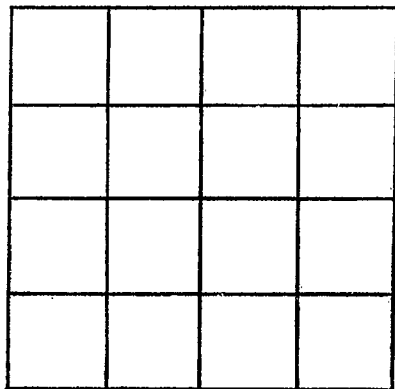

SECTION _____

Please indicate well location X.

ADDITIONAL INFORMATION

If more than one screen, show locations of each on sketch.