

Newton  
G 20 31

MISSISSIPPI DEPARTMENT OF NATURAL RESOURCES  
Bureau of Land and Water Resources  
Southport Mall  
P.O. Box 10631

Jackson, Mississippi 39209  
WATER WELL DRILLERS LOG

8-8-84  
date well completed

McDonald & Hill  
firm name

Newton  
county well located

LANDOWNER:  
Mrs Dovie Adaly  
RT # 2 Decatur  
(mailing address)

WELL LOCATION:  
sec. 7 T 7 N R 12 E  
S W  
2 miles N of Decatur  
(distance) (direction) (nearest town)

WELL PURPOSE: home  
(home, irrigation, municipal, industrial)

- WELL COMPLETION DATA:
- (1) diameter (inches) 4"
  - (2) total depth (feet) 160
  - (3) static water level (feet) 25' below top of ground.
  - (4) casing PVC 40' (material) (depth)  
4" (size) If telescope see back.
  - (5) screen (length) (depth to top)  
(size) (material)
  - (6) pump 1/2 (HP) 4 GPM (material) (yield/gpm)  
K (type power)
  - (7) electric log (yes or no)  
(organization running log)
  - (8) how well bottom plugged open

description of formations encountered	from	to
clay	0	15
sand	15	40
sandy shale	40	50
rock & shale	50	51
shale	51	85
rock & shells	85	100
green sandy sandy shale	100	114
rock shale & sand	114	130
sand	130	145
shale rock & sand	145	160

DEPT. OF NATURAL RESOURCES  
BUREAU OF LAND & WATER RESOURCES


AUG 10 1984

RECEIVED

DRILLERS REMARKS:

If well telescopes please  
sketch and show depths.

GROUND LEVEL

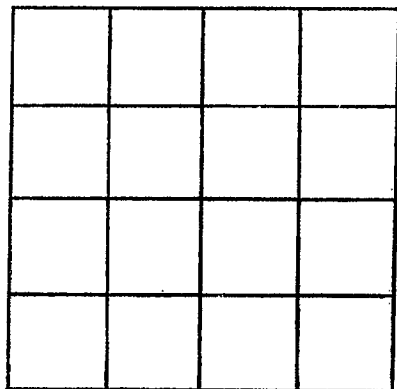

SECTION \_\_\_\_\_

Please indicate well location X.

ADDITIONAL INFORMATION

If more than one screen,  
show locations of each on sketch.