

MISSISSIPPI DEPARTMENT OF NATURAL RESOURCES

Bureau of Land and Water Resources

Southport Mall

P.O. Box 10631

Jackson, Mississippi 39209

WATER WELL DRILLERS LOG

NEWTON  
G 2033

6-28-85  
date well completed

McDONALD + HILL  
firm name

NEWTON  
county well located

LANDOWNER: ANNIE G. WILSON  
416 S MAIN ST  
NEWTON MS  
(mailing address)

WELL LOCATION:  
sec. 31 T. 7 N R. 12 E  
3 miles S of DECATUR  
(distance) (direction) (nearest town)

WELL PURPOSE: HOME  
(home, irrigation, municipal, industrial)

- WELL COMPLETION DATA:
- (1) diameter (inches) 4"
  - (2) total depth (feet) 250
  - (3) static water level (feet) 122 below top of ground.
  - (4) casing PVC 200 (material) (depth) 4" (size) if telescope see back.
  - (5) screen 20 225 (length) (depth to top) 2" PVC (size) (material)
  - (6) pump (HP) (yield gpm) (type power)
  - (7) electric log (yes or no) (organization running log)
  - (8) how well bottom plugged VALVE

description of formations encountered	from	to
Clay	0	18
SAND	18	22
SHALE	22	80
SAND	80	145
FINE SAND + SHALE	145	164
SHALE	164	205
ROCK ST SHELLS	205	225
G SAND	225	235
SAND ST ROCK	235	245
FINE SAND	245	250


RECEIVED  
JUL 5 - 1985

Department of Natural Resources  
Bureau of Land & Water Resources

DRILLERS REMARKS:  
35' 2" PVC  
1-2 x 4 R SEAL

If well telescopes please sketch and show depths.

GROUND LEVEL

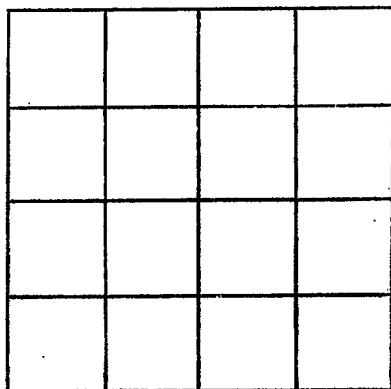

SECTION \_\_\_\_\_

Please indicate well location X.

ADDITIONAL INFORMATION

If more than one screen, show locations of each on sketch.