

Newton
G 2034
7-17-85

MISSISSIPPI DEPARTMENT OF NATURAL RESOURCES
 Bureau of Land and Water Resources
 Southport Mall
 P.O. Box 10631
 Jackson, Mississippi 39209
WATER WELL DRILLERS LOG

L

7-17-85 date well completed McDONALD + WILL firm name NEWTON county well located

LANDOWNER: ANNIE G WILSON
NEWTON MS
 (mailing address)

description of formations encountered	from	to
SAND	0	18
WELLOW SAND	18	22
SHALE	22	90
COURSE SAND	90	145

WELL LOCATION:
 sec. 31 T. 7 N. R. 12 E.
5 miles N of Newton
 (distance) (direction) (nearest town)

WELL PURPOSE: HOME
 (home, irrigation, municipal, industrial)

- WELL COMPLETION DATA:
- (1) diameter (inches) 4"
 - (2) total depth (feet) 145'
 - (3) static water level (feet) 52' below above top of ground.
 - (4) casing PVC 135'
 (material) (depth)
4" if telescope see back.
 (size)
 - (5) screen 10 135
 (length) (depth to top)
4" PVC
 (size) (material)
 - (6) pump 40-50
 (HP) (yield gpm)
 (type power)
 - (7) electric log (yes or no) _____
 (organization running log) _____
 - (8) how well bottom plugged OPEN


RECEIVED
 JUL 28 1985

Department of Natural Resources
 Bureau of Land & Water Resources

DRILLERS REMARKS:
Set pump at 120 ft

If well telescopes please sketch and show depths.

GROUND LEVEL

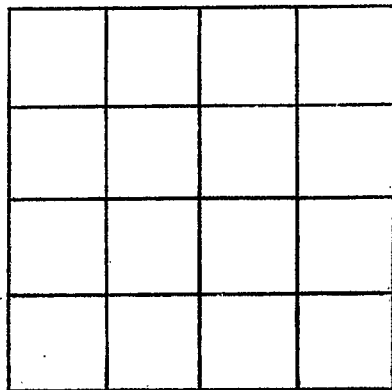

SECTION _____

Please indicate well location X.

ADDITIONAL INFORMATION

If more than one screen,
show locations of each on sketch.