

MISSISSIPPI DEPARTMENT OF NATURAL RESOURCES

Bureau of Land and Water Resources

Southport Mall

P.O. Box 10631

Jackson, Mississippi 39209

WATER WELL DRILLERS LOG

Newton
G
2035

11-14-85 19 McDONALD & HILL NEWTON
 date well completed firm name county well located

LANDOWNER: TALPUS BARHAM
P.O. BOX 313

DECATUR MISS
 (mailing address)

WELL LOCATION:
 sec. 20 T. 7 N. R. 12 E
 S W
1 miles EAST of DECATUR
 (distance) (direction) (nearest town)

WELL PURPOSE: HOME
 (home, irrigation, municipal, industrial)

WELL COMPLETION DATA:

- (1) diameter (inches) 4"
- (2) total depth (feet) 160
- (3) static water level (feet) 58 below above top of ground.
- (4) casing PVC, 8 8'
 (material) (depth)
4" if telescope see back.
 (size)
- (5) screen _____ (length) _____ (depth to top)
 (size) _____ (material) 8
- (6) pump _____ (HP) _____ (yield gpm)
 (type power)
- (7) electric log _____ (yes or no)
 (organization running log)
- (8) how well bottom plugged OPEN

description of formations encountered	from	to
<u>PLAY SAND</u>	<u>0</u>	<u>8</u>
<u>SHALE</u>	<u>8</u>	<u>55</u>
<u>ROCK ST SHELLS</u>	<u>55</u>	<u>90</u>
<u>SAND ST ROCK</u>	<u>90</u>	<u>110</u>
<u>SAND</u>	<u>110</u>	<u>122</u>
<u>GREEN SAND</u>	<u>122</u>	<u>130</u>
<u>SANDY</u>	<u>130</u>	<u>142</u>
	<u>142</u>	<u>160</u>


RECEIVED
 NOV 18 1985

DRILLERS REMARKS:

Department of Natural Resources
 Bureau of Land & Water Resources

If well telescopes please sketch and show depths.

GROUND LEVEL

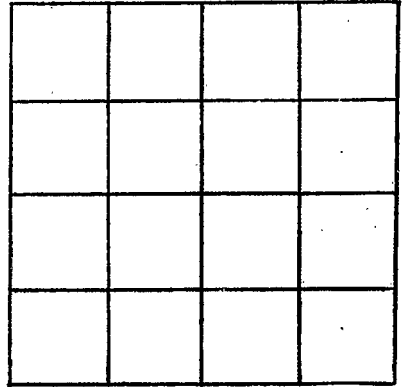

SECTION _____

Please indicate well location X.

ADDITIONAL INFORMATION

If more than one screen,
show locations of each on sketch.