

6 NEWTON
#2

MISSISSIPPI BOARD OF WATER COMMISSIONERS

WATER WELL DRILLERS LOG

11-14-61

Date: 11-14, 1961, Driller: R R Nicholas, County Newton
(Name)

(1) Owner of Land:	Description & Color of Materials Sand, Clay, Red Clay, Shell, etc.	Thick- ness Feet	Depth Feet
Cecil Barnett (Name) Union Miss (city) (Address)	1-3.5 Chalk mix sand & mud	1 3.5	35 48
(2) Location: 1/4, 1/4, Sec. 2 T ^{7N} R ^{13E} 11 miles east of Decatur (distance) (direction) (Nearest Town)	blue dirt rock rock hard water sand	48 120 180 200	120 180 200 235
(3) Topography: <input checked="" type="checkbox"/> (Hilly) <input type="checkbox"/> (Flat) <input type="checkbox"/> (Level)			
(4) Purpose of Well: Domestic (Domestic Irrigation Municipal, Industrial, Other)			

Information upon completion of well:

(1) Diameter 4 1/2 inches.

(2) Total Depth 235 feet.

(3) Water Level 00 feet below top of ground.

(4) Cased to 105, Size 2"


(5) Screen: Size _____, Length _____

(6) Were any formations sealed against pollution?
_____ yes, _____ no.

If YES depth of formation _____

Why _____

Drillers Remarks: This well has 88 ft of rock very hard

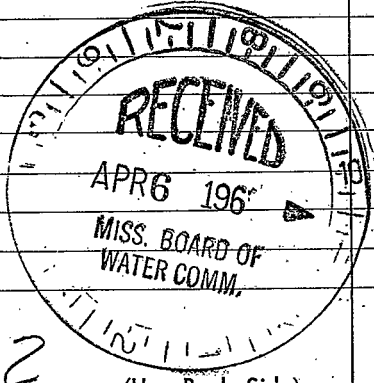

2

(Use Back Side)

Well No.

1944

1945

1946

1960