

H3
10-8-61

WATER WELL DRILLERS LOG

Date: 10-8, 1961, Driller: R. R. Nicholas County Newton
(Name)

(1) Owner of Land: Harvey Sowell
(Name)
Union Mill Pt 4
(Address)

(2) Location: 1/4, 1/4, Sec. 9 ^{T₁N} _{R₁₃E}
12 miles South-E of Union
(distance) (direction) (Nearest Town)

(3) Topography: X
(Hilly) (Flat) (Level)

(4) Purpose of Well: Domestic
(Domestic Irrigation
Municipal, Industrial, Other)

Description & Color of Materials Sand, Clay, Red Clay, Shell, etc.	Thick- ness Feet	Depth Feet
<u>Clay & Chalk</u>	<u>1</u>	<u>30</u>
<u>Slide dirt</u>	<u>30</u>	<u>75</u>
<u>Water sand</u>	<u>75</u>	<u>95</u>

Information upon completion of well:

(1) Diameter 4 1/2 inches.

(2) Total Depth 95 feet.

(3) Water Level 30 feet below top of ground.


(4) Cased to 63, Size 2"

(5) Screen: Size _____, Length _____.

(6) Were any formations sealed against pollution?
_____ yes, _____ no.

If YES depth of formation _____
Why _____

Drillers Remarks: this is an open well

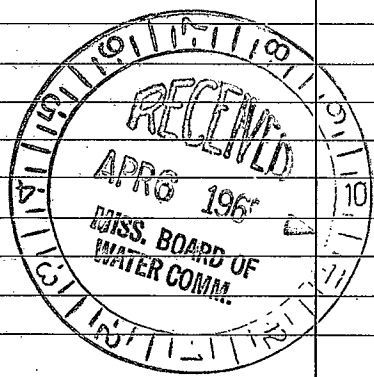

(Use Back Side)

Well No.

