

H5

9-19-64

WATER WELL DRILLERS LOG

Date: 9-19, 1964, Driller: Bob Williams, County Newton  
(Name)

(1) Owner of Land: L. B. Alexander  
(Name)  
Rt 2, Box 75, Little Rock  
SE (Address)

(2) Location: S 1/2 1/4, SE 1/4, Sec. 11 T. 7 R. 12  
1.5 miles west of Meridian  
(distance) (direction) (Nearest Town)

(3) Topography: hilly  
(Hilly) (Flat) (Level)


(4) Purpose of Well: domestic  
(Domestic Irrigation  
Municipal, Industrial, Other)

Description & Color of Materials Sand, Clay, Red Clay, Shell, etc.	Thick-ness Feet	Depth Feet
Red sand	15	1-15
gray sand	15	15-30
Blue clay	140	30-170
gray sand	42	170-212

Information upon completion of well:

- (1) Diameter 2 inches.
- (2) Total Depth 212 feet.
- (3) Water Level 22 feet below top of ground.
- (4) Cased to 63, Size 2"
- (5) Screen: Size 0, Length
- (6) Were any formations sealed against pollution?  
 yes,  no.

If YES depth of formation  
Why surface  
Drillers Remarks:

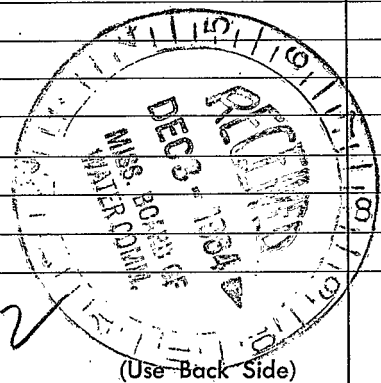

Well No.

