

NEWTON
H 8
4-68

MISSISSIPPI
BOARD OF WATER COMMISSIONERS
416 North State Street
Jackson, Mississippi 39201

WATER WELL DRILLERS LOG

April 22 1968 William Drilling Co Newton
date well completed firm name county well located

LANDOWNER:	description of formations encountered	from	to
<u>R. D. Smith</u>	<u>Red sand</u>	<u>1</u>	<u>20</u>
<u>Pt 1 Chumby, Miss.</u>	<u>Rock</u>	<u>20</u>	<u>30</u>
(mailing address)	<u>White sand</u>	<u>30</u>	<u>95</u>

WELL LOCATION:
sec. 24 T 7 N R 13 E
8 miles N of Chumby
(distance) (direction) (nearest town)

WELL PURPOSE: Home
(home, irrigation, municipal, industrial)


- WELL COMPLETION DATA:
- (1) diameter (inches) 2
 - (2) total depth (feet) 95
 - (3) static water level (feet) 55 below above top of ground.
 - (4) casing 2" PXR, 90
(material) (depth)
2" if telescope see back.
(size)
 - (5) screen 5 ft, 90
(length) (depth to top)
12 stainless steel
(size) (material)
 - (6) pump 1-Act 5
(HP) (yield gpm)
Elect
(type power)
 - (7) electric log no
(yes or no)
no
(organization running log)
 - (8) how well bottom plugged Cap

DRILLERS REMARKS:

MAY 22 1968
MISS. REG. 24
WATER BOARD

If well telescopes please
sketch and show depths.

GROUND LEVEL

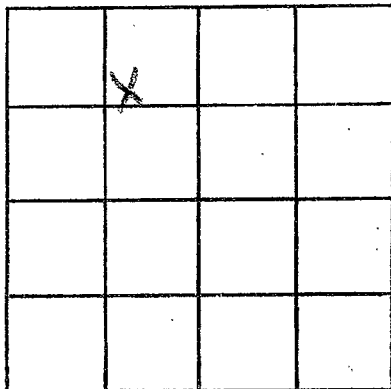

SECTION 24

Please indicate well location X.

ADDITIONAL INFORMATION

If more than one screen,
show locations of each on sketch.