

Newton
H 11
2-10-73

MISSISSIPPI
 BOARD OF WATER COMMISSIONERS
 416 North State
 Jackson, Mississippi 39201

WATER WELL DRILLERS LOG

2/10 1973 Harold Poole Newton
 date well completed firm name county well located

LANDOWNER: George D. Estes
Route #2 Box 39
Little Rock, Ms.
 (mailing address)

description of fomations encountered	from	to
	Red Surface Clay	0'

WELL LOCATION:
 sec. 5 T. 7^N_S R. 13^E_W
9 miles East of Decatur
 (distance) (direction) (nearest town)

White sand down to rock	9'	25'
-------------------------	----	-----

WELL PURPOSE: Home
 (home, irrigation, municipal, industrial)

WELL COMPLETION DATA:

(1) diameter (inches) 2 inches
 (2) total depth (feet) 25
 (3) static water level (feet) 12 ^{below} ~~above~~ top of ground.
 (4) casing Plastic 20'
 (material) (depth)
 If telescope see back.
 (size)
 (5) screen 5' 20'
 (length) (depth to top)
2" Stainless 10/10
 (size) (material)
 (6) pump 1 7
 (HP) (yield gpm)
Electric
 (type power)
 (7) electric log
 (yes or no)


 (organization running log)
 (8) how well bottom plugged Galv.
Cap on end of screen

CODED

DRILLERS REMARKS:

If well telescopes please sketch and show depths.

GROUND LEVEL

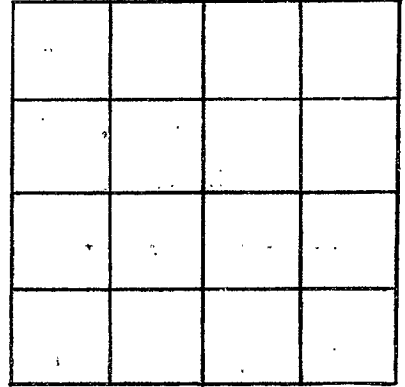

SECTION _____

Please indicate well location X.

ADDITIONAL INFORMATION

If more than one screen,
show locations of each on sketch.