

MISSISSIPPI  
BOARD OF WATER COMMISSIONERS  
416 North State Street  
Jackson, Mississippi 39201

**CODED**

WATER WELL DRILLERS LOG

Newton  
H 12  
6-13-73

6.13.73  
date well completed

McDonald + Hill  
firm name

Newton  
county well located

LANDOWNER:  
W. H. JONES  
R# 2 LITTLE ROCK  
(mailing address)

description of formations encountered	from	to
<u>Clay</u>	<u>0</u>	<u>5</u>
<u>Rock ST shale</u>	<u>5</u>	<u>45</u>
<u>shale</u>	<u>45</u>	<u>105</u>
<u>sand</u>	<u>105</u>	<u>78</u>
<u>sandy</u>	<u>78</u>	<u>80</u>

WELL LOCATION:  
sec. 10 T. 7 N. R. 13 E  
5 miles S. WEST of DOFFEE  
(distance) (direction) (nearest town)

WELL PURPOSE: WATER  
(home, irrigation, municipal, industrial)

- WELL COMPLETION DATA:
- (1) diameter (inches) 4 1/2
  - (2) total depth (feet) 80
  - (3) static water level (feet) 52 below top of ground.
  - (4) casing pvc, 68' (material) (depth)  
4 1/2 (size) If telescope see back.
  - (5) screen 10, 68' (length) (depth to top)  
4 1/2, pvc (size) (material)
  - (6) pump 1/2 sub, 10 (HP) (yield gpm)  
220 (type power)
  - (7) electric log \_\_\_\_\_ (yes or no)  
\_\_\_\_\_  
(organization running log)
  - (8) how well bottom plugged VALUE


**CODED**

JUN 18 1973

DRILLERS REMARKS:

If well telescopes please sketch and show depths.

GROUND LEVEL

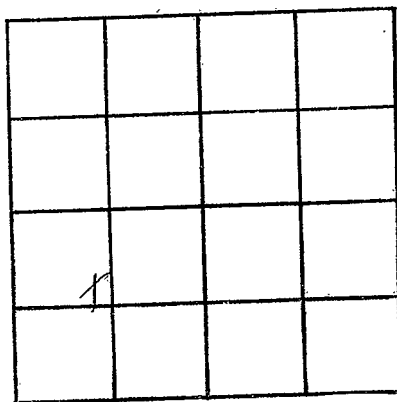

SECTION \_\_\_\_\_

Please indicate well location X.

ADDITIONAL INFORMATION

If more than one screen, show locations of each on sketch.