

Newton
H 13
7-18-75

MISSISSIPPI
BOARD OF WATER COMMISSIONERS
416 North State Street
Jackson, Mississippi 39201

WATER WELL DRILLERS LOG CODED

7.18.75 19 McDonald + Hill NEWTON
date well completed firm name county well located

LANDOWNER:
ROGER CULPEPPER
HICKORY
(mailing address)

WELL LOCATION:
sec. 35 T 7 N R 13 E 13P
4 1/2 miles NORTH of CHUNKY
(distance) (direction) (nearest town)

WELL PURPOSE:
ET AAR
(home, irrigation, municipal, industrial)


- WELL COMPLETION DATA:
- (1) diameter (inches) 4"
 - (2) total depth (feet) 280'
 - (3) static water level (feet) 175' below top of ground.
 - (4) casing PVC 115' (material) (depth)
4" if telescope see back. (size)
 - (5) screen (length) (depth to top)
(size) (material)
 - (6) pump 1/2 Sub (HP) (yield gpm)
E (type power)
 - (7) electric log (yes or no)
(organization running log)
 - (8) how well bottom plugged OPEN

description of formations encountered	from	to
Clay sand	0	40
Shale	40	44
Clay shale	44	50
hard Rock	50	65
yellow sand	65	102
Clay	102	109
shale	109	116
Rock ST shale	116	195
sand	195	230
hard shale	230	280
CODED		
RECEIVED JUL 28 1975		
MISS. RD. OF WATER COMMISSIONERS		

DRILLERS REMARKS:

If well telescopes please sketch and show depths.

GROUND LEVEL

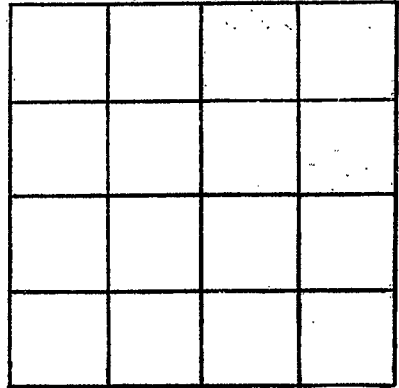

SECTION _____

Please indicate well location X.

ADDITIONAL INFORMATION

If more than one screen,
show locations of each on sketch.