

Newton
H 14
10-30-69

MISSISSIPPI
 BOARD OF WATER COMMISSIONERS
 416 North State Street
 Jackson, Mississippi 39201

CODED

WATER WELL DRILLERS LOG

10-30-69 date well completed W. Williamson Drilling Co. firm name Newton county well located

LANDOWNER Johanny Turner
Wt 2
Deator
 (mailing address)

description of formations encountered	from	to
	<u>top soil</u>	<u>0</u>
<u>red sand</u>	<u>4</u>	<u>33</u>
<u>rock & clay</u>	<u>33</u>	<u>180</u>
<u>sand</u>	<u>180</u>	<u>215</u>

WELL LOCATION:
 sec 6 T 70 S R 13E
5 miles S of Little Rock
 (distance) (direction) (nearest town)

WELL PURPOSE: Home
 (home, irrigation, municipal, industrial)

- WELL COMPLETION DATA:
- (1) diameter (inches) 4
 - (2) total depth (feet) 215
 - (3) static water level (feet) 80 below top of ground.
 - (4) casing Black 110
 (material) (depth)
 - 4 if telescope see back.
 (size)
 - (5) screen no
 (length) (depth to top)
 - (size) (material)
 - (6) pump 2 10
 (HP) (yield gpm)
 - Electric
 (type power)
 - (7) electric log no
 (yes or no)
 - no
 (organization running log)
 - (8) how well bottom plugged open


JAN - 5 1970

DRILLERS REMARKS:

MISS. Bd. OF
 WATER COMM.

If well telescopes please sketch and show depths.

GROUND LEVEL

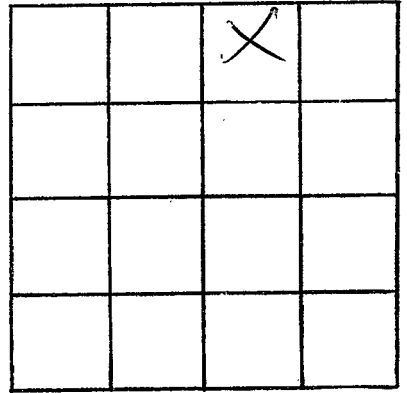

SECTION 6

Please indicate well location X.

ADDITIONAL INFORMATION

If more than one screen,
show locations of each on sketch.