

NEWTON
H 15
6-18-73

MISSISSIPPI
 BOARD OF WATER COMMISSIONERS
 416 North State Street
 Jackson, Mississippi 39201

CODED

WATER WELL DRILLERS LOG

6-18-73 date well completed 19 Williamson Drilling Co. firm name Newton county well located

LANDOWNER: Donald Butts
Chumby Wis.

description of formations encountered	from	to
<u>red clay</u>	<u>0</u>	<u>12</u>
<u>red sand</u>	<u>12</u>	<u>23</u>
<u>rock clay</u>	<u>23</u>	<u>178</u>
<u>sand</u>	<u>178</u>	<u>161</u>

(mailing address)

WELL LOCATION:

sec 36 T 7N R B E

350 miles North of Chumby
 (distance) (direction) (nearest town)

WELL PURPOSE: Home
 (home, irrigation, municipal, industrial)

WELL COMPLETION DATA:

- (1) diameter (inches) 2
- (2) total depth (feet) 161
- (3) static water level (feet) 45 below above top of ground.
- (4) casing metal, 156,
 (material) (depth)
2 if telescope see back.
 (size)
- (5) screen 5, 156
 (length) (depth to top)
12, plastic
 (size) (material)
- (6) pump 1 7
 (HP) (yield gpm)
elect.
 (type power)
- (7) electric log no
 (yes or no)
no
 (organization running log)
- (8) how well bottom plugged Cap


CODED

DRILLERS REMARKS:

OCT 31 1973

If well telescopes please sketch and show depths.

GROUND LEVEL

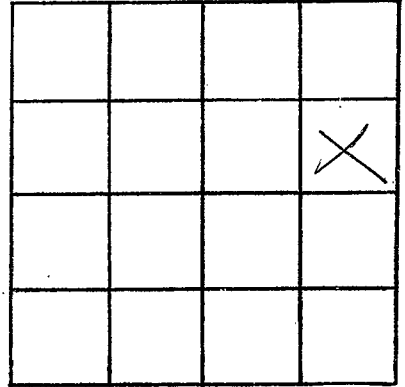

SECTION 35

Please indicate well location X.

ADDITIONAL INFORMATION

If more than one screen,
show locations of each on sketch.