

NEWTON
H 16
9-15-73

MISSISSIPPI
 BOARD OF WATER COMMISSIONERS
 416 North State Street
 Jackson, Mississippi 39201

CODED

WATER WELL DRILLERS LOG

Sept. 15 19 73 Harold Poole Newton
 date well completed firm name county well located

LANDOWNER: Denver Estes
Rt. 2

description of formations encountered from to

Little Rock, Miss.
 (mailing address)

Red clay 0 16
 Sand 16 20

WELL LOCATION:
 sec. 5 T. 7 N R. 13 E
9 miles east of Decatur
 (distance) (direction) (nearest town)

Layer of White clay and sand mixed 20 26
 White sand, course 26 52

WELL PURPOSE: Home
 (home, irrigation, municipal, industrial)

WELL COMPLETION DATA:

- (1) diameter (inches) 2 inches
- (2) total depth (feet) 52
- (3) static water level (feet) 26 below above top of ground.
- (4) casing plastic 47'
 (material) (depth)
2"
 (size) If telescope see back.
- (5) screen 5' 47'
 (length) (depth to top)
1 1/2 Plastic
 (size) (material)
- (6) pump 1 9
 (HP) (yield gpm)
electric 220
 (type power)
- (7) electric log _____
 (yes or no)

 (organization running log)

CODED

OCT 17 1973


(8) how well bottom plugged Pointed
Plastic screen

STATE OF MISSISSIPPI
 BOARD OF WATER COMMISSIONERS

DRILLERS REMARKS:

If well telescopes please
sketch and show depths.

GROUND LEVEL

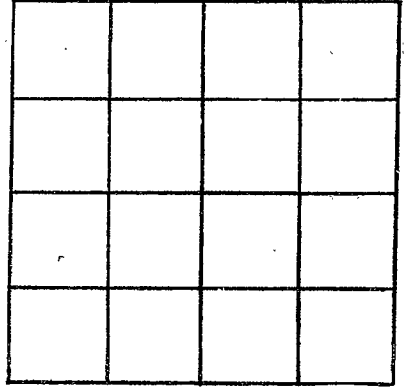

SECTION _____

Please indicate well location X.

ADDITIONAL INFORMATION

If more than one screen,
show locations of each on sketch.