
State W	ell Report				
	art 1	For Office Use Only:			
	t of Environmental Quality	Aquifer:			
	nd Water Resources	Well #: H - 24			
Difficil	Box 10631 IS 39289-0631	•			
Date drilling completed: 12+9-05 (601)	961-5210	L. S. Elevation:			
(601)354	4-6938 (fax)	E-log #:			
State Law requires that this report be prepared by the driller in detail and filed with the Department within 30 days of completion of drilling of the well.					
Well Owner Information	Well	Location			
		" Longitude: 50 • CO • 14 "			
Mailing Address: 12623 - Hickory Cyl Rose Method of Lat/Long (circle one): Conventional Survey,					
	USGS quad, Hand-held	GPS, Survey-grade GPS			
City State Zip Code 7 St 14 Sec 7 Twn 7N Rng 13E					
Telephone No. 601, -635 - 5296	Distance Direction Miles	of			
Well Data Well Circle one) Home Industrial Public Supply Irrigation Fish Culture Other:					
Date well drilling started: 12-12-05 Date well drilling completed: 12-19-05					
If flowing, method of flow regulation: Valve Other (describe)					
Static Water Level: feet above or below (circle one) land surface Date measured: BECT!					
Method of Measurement (circle one) steel tape electric tape air line other:					
Hole depth: Well depth: Well grouted to a depth of					
Type of grout (circle one): Cement Bentonite Mix					
Casing length: 20 feet Casing diameter:					
Screen length: 20 feet Screen diameter: 4 inches Type of screen: WC Johnson					
Screen slot size:					
Type of completion (circle all applicable): Gravel packed Underreamed Telescoped Open hole Natural Development					
Other (describe):					
Top of lap pipe or reduction in casing:feet. If telescoped or more than one screen, describe on back of page					
Logs run (circle all applicable): No log run Electric Gamma Ray Density Sonic Neutron Other:					
Name of organization running log(s):					
I certify that the well was drilled, constructed, and completed in accordance with all applicable requirements of the Mississippi					
Department of Environmental Quality and/or the Mississippi Department of Health regulations and state laws.					
MEDONAL & Hie Duc. # 0-8 Hard thee					
Print Name of Water Well Contractor and License No.	V Signature of V	Water Well Contractor			

H-24

Ground Level		Description of Formations Encountered	From	To	
	· · · · · · · · · · · · · · · · · · ·	Clay, SAND, NOCK	15	es V	ර
		Portay, St Shale	40	15	D
		SAMO	150	17	0
		Shale	170	20	0
		SAMOY STATE	200	22	0
	2 14	Shale	220	24	0
$H\rangle$	-10 squa	(5)			
<u></u>	-20'SGREA Blank				
	BLANK				
ن.					

If more than one screen, show location of each on sketch

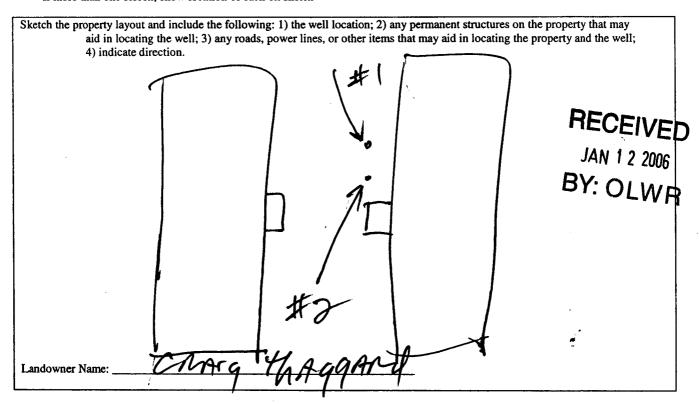

Signature of Water Well Contractor

STATE WELL REPORT

Comment of the sale	Part Z	For Office Use Only:		
County: YOUNT Missi	Installer's Completion Report issippi Department of Environmental Quality	Aquifer:		
Permit #:	Office of Land and Water Resources	Aquiter.		
Driller: KONACA F KEE	P.O. Box 10631	Well #: H - 24		
1-9-16	Jackson, MS 39289-0631 (601)961-5210			
Date completed:	(601)354-6938 (fax)	Elevation:		
This report should be prepared by the nump	installer in detail and filed with the Departme	ant within 30 days of the		
installation of pump.	instanci in detan and med with the Departme	ent within 50 days of the		
Well Owner Information	We	ell Location		
Owner Name: MAG Thage	And Latitude:	Longitude:		
12/0/2 1/ 1/		-		
Mailing Address: 10009 - THERE	Circle of Lat/Long (circle of	one): Conventional Survey,		
	USGS quad. Han	d-held GPS, Survey-grade GPS		
C. Headay				
City State	7in Code 773 4 4 Sec_	7 Twn 7 N Rng 13 F		
City State	Distance Direction	Nearest Town		
- CAI 125-529	$\frac{1}{2}$ $\frac{1}{2}$ Miles N	Hickory		
Telephone No (20) 1655 - 3 149	Miles	of // 4cac		
Pump Type		ower Type		
Circle one		Circle one		
Air Lift Jet Subm	Diesel Engine Gasol	ine Engine Natural Gas		
Bucket Piston Turbin	ne Electric Motor Hand	Tractor PTO		
Centrifugal Rotary Flowi	ing Well Windmill Other	(specify):		
Other (specify):	Horse Power Rating of Moto	r: >		
Date Pump Installed: 1-9-06	•			
7.				
Rated Pump Capacity:				
		MECEIVE		
Pump Test Data		easuring Water Level		
Date Well Tested: 1-9-66	<u> </u>	Circle one JAN 1 2 2006		
Static Water Level (A): 120 Feet Below Land Surface Air Line Electric Measuring Line Steel By: O		asuring Line Steel By: O		
Pumping Water Level (B): 180 Feet Below Land Surface Other (specify): Sharpy				
7 5	7.0			
Por flowing well, measured shut in head:				
Test rumping Rate: Gallons	Test Pumping Rate:Gallons Per Minute Well yieldedGPM with a drawdown of			
Duration of Pump Test (minimum 4 hours):	ration of Pump Test (minimum 4 hours):hourshours of pumping			
I HEREBY CERTIFY that the above statements are true to the best of my knowledge.				
INTOWARD & Hel. FNC. WU-8 / larold the				

Signature of Pump Installer

Print Name of Pump Installer and License No. (if applicable)