

Newton
H 2001
8-10-76

MISSISSIPPI
 BOARD OF WATER COMMISSIONERS
 416 North State Street
 Jackson, Mississippi 39201

WATER WELL DRILLERS LOG

8.10.76 19 McDonnell Hill NEWTON
 date well completed firm name county well located

LANDOWNER:
WILLIE THORN
R# 2 DECATUR
 (mailing address)

description of formations encountered	from	to
<u>Clay sand</u>	<u>0</u>	<u>14</u>
<u>sand</u>	<u>14</u>	<u>50</u>
<u>Shale</u>	<u>50</u>	<u>92</u>
<u>Rocky shale</u>	<u>92</u>	<u>124</u>
<u>Green sand</u>	<u>124</u>	<u>160</u>
<u>sand</u>	<u>160</u>	<u>200</u>

WELL LOCATION:
 sec. 26 T 7 N R 16 E 13
 S W
5 miles EAST of DECATUR
 (distance) (direction) (nearest town)

WELL PURPOSE: HOME
 (home, irrigation, municipal, industrial)

- WELL COMPLETION DATA:
- (1) diameter (inches) 4"
 - (2) total depth (feet) 200'
 - (3) static water level (feet) 84' below top of ground.
 - (4) casing PVC 91'
 (material) (depth)
 (size) if telescope see back.
 - (5) screen _____
 (length) (depth to top)
 (size) (material)
 - (6) pump 1/2 sub 10
 (HP) (yield gpm)
5
 (type power)
 - (7) electric log _____
 (yes or no)
 (organization running log)
 - (8) how well bottom plugged OPEN


DRILLERS REMARKS:

RECEIVED
 AUG 16 1976

MISS. BD. OF WATER COMMISSIONERS

If well telescopes please sketch and show depths.

GROUND LEVEL

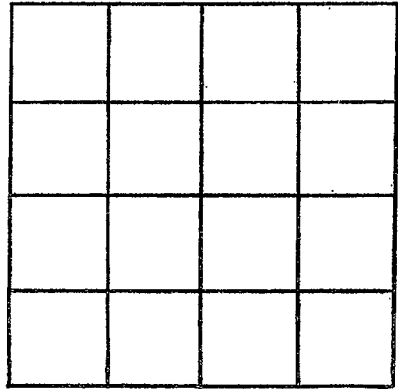

SECTION _____

Please indicate well location X.

ADDITIONAL INFORMATION

If more than one screen,
show locations of each on sketch.