

Newton  
A 2002  
7-18-77

MISSISSIPPI  
BOARD OF WATER COMMISSIONERS  
416 North State Street  
Jackson, Mississippi 39201

WATER WELL DRILLERS LOG

7-18-77 date well completed  
19 Williamson Drilling Co. firm name  
Newton county well located

LANDOWNER: Albert Tracy	description of formations encountered	from	to
Box 120	top soil	0	2
Chunky (mailing address)	red sand	2	18
	rock & clay	18	40
	blue clay	40	85
	sand	85	170

WELL LOCATION:  
sec. 28 T 70 N R. 13 E  
S W  
7 miles N of Chunky  
(distance) (direction) (nearest town)

WELL PURPOSE: Abund  
(home, irrigation, municipal, industrial)

WELL COMPLETION DATA:


- (1) diameter (inches) 1
- (2) total depth (feet) 110
- (3) static water level (feet) 40 (below/above top of ground)
- (4) casing PVC 105 (material) (depth)  
2 (size) If telescope see back.
- (5) screen 5 105 (length) (depth to top)  
12 PVC (size) (material)
- (6) pump 1 8 (HP) (yield gpm)  
Eliot (type power)
- (7) electric log no (yes or no)  
no (organization running log)
- (8) how well bottom plugged Cap

DRILLERS REMARKS:

RECEIVED  
NOV 29 1977  
M.S. BD. OF WATER COMMISSIONERS

If well telescopes please sketch and show depths.

GROUND LEVEL

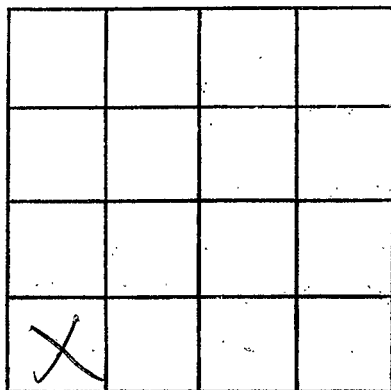

SECTION 28

Please indicate well location X.

ADDITIONAL INFORMATION

If more than one screen, show locations of each on sketch.