

NEWTON
H 2003
8-20-77

MISSISSIPPI
BOARD OF WATER COMMISSIONERS
416 North State Street
13P Jackson, Mississippi 39201

WATER WELL DRILLERS LOG

AUGUST 20 1977 HAROLD POOLE NEWTON
date well completed firm name county well located

LANDOWNER: W. D. DANIELS
RT 2, LITTLE
Rock, MISS.
(mailing address)

WELL LOCATION:
sec. 15 T. 7 N R. 13 E
8 miles N of CHUNKY
(distance) (direction) (nearest town)

WELL PURPOSE: HOME
(home, irrigation, municipal, industrial)

WELL COMPLETION DATA:
(1) diameter (inches) 2"
(2) total depth (feet) 55 ft
(3) static water level (feet) 38' below above top of ground.
(4) casing: Pvc 50 (material) (depth)
(size) If telescope see back.
(5) screen: 5' 50' (length) (depth to top)
2" Pvc (size) (material)
(6) pump: 1 1/2 7 (HP) (yield gpm)
220 (type power)
(7) electric log (yes or no)
(organization running log)
(8) how well bottom plugged: SPARK TOOTH

description of formations encountered	from	to
SURFACE CLAY	0'	12'
RED		
WHITE CHALK		
CLAY	12'	21'
COARSE SAND		
RED TENT	21'	40'
COARSE SAND		
WHITE	40'	55'
BOTTOMED		
OUT ON BLUE GRAY SHELL		

DRILLERS REMARKS: CUSTOMER OWNED HIS PUMP


RECEIVED

SEP 20 1977

MISS. BD. OF WATER COMM

If well telescopes please sketch and show depths.

GROUND LEVEL

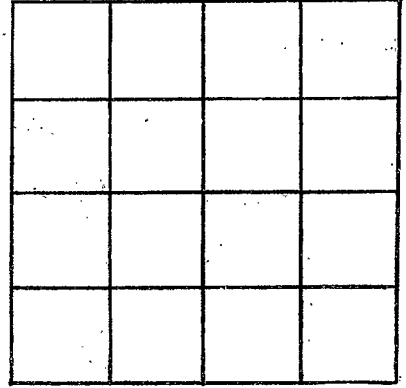

SECTION _____

Please indicate well location X.

ADDITIONAL INFORMATION

If more than one screen,
show locations of each on sketch.