

NEWTON

H 2006

8-19-78

MISSISSIPPI
 BOARD OF WATER COMMISSIONERS
 416 North State Street
 Jackson, Mississippi 39201

WATER WELL DRILLERS LOG

AUGUST 19 1978 HAROLD POOLE NEWTON
 date well completed firm name county well located

LANDOWNER:

ERNEST O. MABRY

RT. 2 BOX 73A LITTLE ROCK
 (mailing address) MISS.

WELL LOCATION:

sec. 12 T 7 N R 13 E
1 miles South of DUFFEE
 (distance) (direction) (nearest town)

WELL PURPOSE: HOME
 (home, irrigation, municipal, industrial)

WELL COMPLETION DATA:

- (1) diameter (inches) 4"
- (2) total depth (feet) 165'
- (3) static water level (feet) 5' below above top of ground.
- (4) casing PVC, 61'
 (material) (depth)
 (size) If telescope see back.
- (5) screen OPEN
 (length) (depth to top)
 (size) (material)
- (6) pump 3/4 SUB-20
 (HP) (yield gpm)
220 ELECTRIC
 (type power)
- (7) electric log _____
 (yes or no)
 (organization running log)
- (8) how well bottom plugged _____

description of formations encountered

from to

RED SURFACE-CLAY 0' 3'

BLUE SHELL 3' 120'

SAND 120' 165'

DRILLERS REMARKS:


RECEIVED

DEC 13 1978

MISS. BD. OF WATER COMM

If well telescopes please
sketch and show depths.

GROUND LEVEL

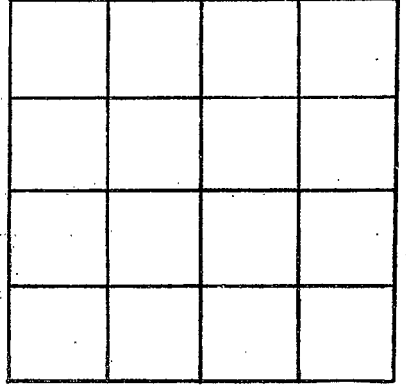

SECTION _____

Please indicate well location X.

ADDITIONAL INFORMATION

If more than one screen,
show locations of each on sketch.