

Newton  
H 2007  
12-4-79

MISSISSIPPI  
BOARD OF WATER COMMISSIONERS  
416 North State Street  
Jackson, Mississippi 39201

WATER WELL DRILLERS LOG

12-4-79 19 McDonald & Hill Newton  
date well completed firm name county well located

LANDOWNER:	description of formations encountered	from	to
Lindsey Rose Rt # 1 Hickory (mailing address)			
	sand	17	30
	Rock & shale	30	140
	sand & sandy shale	140	160
	sand	160	180

WELL LOCATION:  
sec. 32 T 7 N R 13 E  
6 miles N of Hickory  
(distance) (direction) (nearest town)

WELL PURPOSE: home  
(home, irrigation, municipal, industrial)


- WELL COMPLETION DATA:
- (1) diameter (inches) 4"
  - (2) total depth (feet) 180'
  - (3) static water level (feet) 50' below top of ground.
  - (4) casing PVC 80'  
(material) (depth)  
4" If telescope see back.  
(size)
  - (5) screen  
(length) (depth to top)  
(size) (material)
  - (6) pump 1/2 60 gpm  
(HP) (yield gpm)  
F  
(type power)
  - (7) electric log (yes or no)  
(organization running log)
  - (8) how well bottom plugged open

DRILLERS REMARKS:

DEPT. OF NATURAL RESOURCES  
BUREAU OF LAND & WATER RESOURCES  
DEC 11 1979  
RECEIVED

If well telescopes please sketch and show depths.

GROUND LEVEL

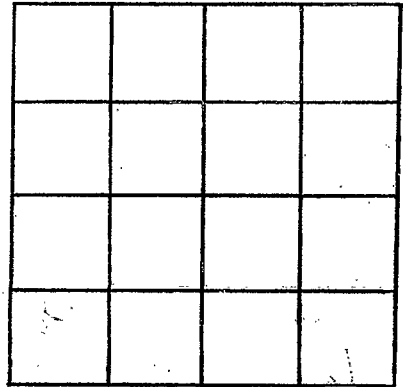

SECTION \_\_\_\_\_

Please indicate well location X.

ADDITIONAL INFORMATION

If more than one screen,  
show locations of each on sketch.