

Newton
H 2008
12-4-79

MISSISSIPPI
BOARD OF WATER COMMISSIONERS
416 North State Street
Jackson, Mississippi 39201

WATER WELL DRILLERS LOG

12-4-79 19 *McDonnell Well* *Newton*
date well completed firm name county well located

LANDOWNER:	description of formations encountered	from	to
J.E. Booze	clay & sand	0	45
Rt # 1 Hickory (mailing address)	rock shale	45	150
WELL LOCATION: sec. <u>32</u> T <u>70</u> N R <u>13</u> E <u>6</u> miles <u>N</u> of <u>Hickory</u> (distance) (direction) (nearest town)	wandy shale & sand	150	170
WELL PURPOSE: <u>home</u> (home, irrigation, municipal, industrial)	sand	170	200
WELL COMPLETION DATA:			
(1) diameter (inches) <u>4"</u>			
(2) total depth (feet) <u>200'</u>			
(3) static water level (feet) <u>70'</u> below top of ground.			
(4) casing <u>PVC</u> , <u>103'</u> (material) (depth) <u>4"</u> (size) if telescope see back.			
(5) screen _____ (length) (depth to top) _____ (size) (material)			
(6) pump <u>1/2</u> <u>6 gpm</u> (HP) (yield gpm) <u>F</u> (type power)			
(7) electric log _____ (yes or no) _____ (organization running log)			
(8) how well bottom plugged <u>open</u>			
DRILLERS REMARKS:			


DEPT. OF NATURAL RESOURCES
BUREAU OF LAND & WATER RESOURCES

DEC 11 1979

RECEIVED

If well telescopes please sketch and show depths.

GROUND LEVEL

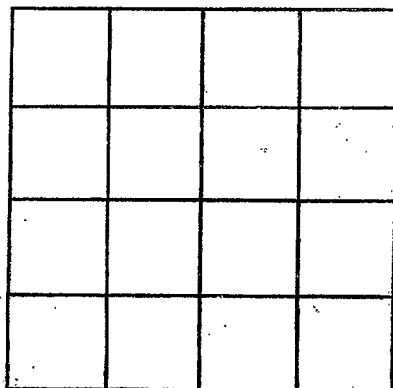

SECTION _____

Please indicate well location X.

ADDITIONAL INFORMATION

If more than one screen,
show locations of each on sketch.