

MISSISSIPPI DEPARTMENT OF NATURAL RESOURCES

Bureau of Land and Water Resources

Southport Mall

P.O. Box 10631

Jackson, Mississippi 39209

WATER WELL DRILLERS LOG

Newton
H 2010
5-26-81
5-26-81

date well completed

firm name

county well located

McDonald & Hill

Newton

LANDOWNER:	description of formations encountered	from	to
<u>T. J. Archie</u>	<u>clay</u>	<u>0</u>	<u>10</u>
<u>Chunky</u> (mailing address)	<u>sand</u>	<u>10</u>	<u>50</u>
WELL LOCATION:	<u>sandy shale</u>	<u>50</u>	<u>60</u>
sec <u>34</u> T <u>7</u> N R <u>13</u> E	<u>shale</u>	<u>60</u>	<u>78</u>
<u>8</u> miles <u>N</u> of <u>Chunky</u>	<u>Rock & shells</u>	<u>78</u>	<u>100</u>
(distance) (direction) (nearest town)	<u>sand</u>	<u>100</u>	<u>120</u>
WELL PURPOSE: <u>home</u> (home, irrigation, municipal, industrial)	<u>Rock & shale</u>	<u>120</u>	<u>220</u>
WELL COMPLETION DATA:	<u>sandy shale & sand</u>	<u>220</u>	<u>235</u>
(1) diameter (inches) <u>4"</u>	<u>sand</u>	<u>235</u>	<u>260</u>
(2) total depth (feet) <u>260'</u>			
(3) static water level (feet) <u>170'</u> below top of ground.			
(4) casing <u>PVC</u> , <u>200'</u> (material) (depth)			
<u>4"</u> (size) if telescope see back.			
(5) screen _____ (length) (depth to top)			
(size) (material)			
(6) pump <u>3/4</u> <u>99 gpm</u> (HP) (yield gpm)			
(type power)			
(7) electric log _____ (yes or no)			
(organization running log)			
(8) how well bottom plugged <u>open</u>			

DRILLERS REMARKS:


DEPT. OF NATURAL RESOURCES
BUREAU OF LAND & WATER RESOURCES

JUN 2 - 1981

RECEIVED

If well telescopes please sketch and show depths.

GROUND LEVEL

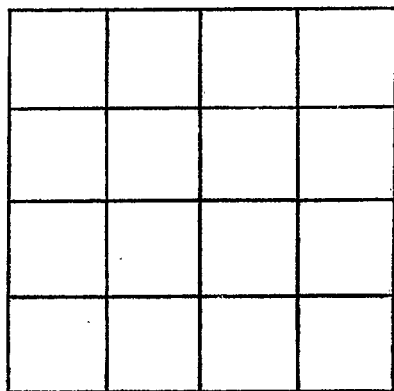

SECTION _____

Please indicate well location X.

ADDITIONAL INFORMATION

If more than one screen, show locations of each on sketch.