

MISSISSIPPI DEPARTMENT OF NATURAL RESOURCES

Bureau of Land and Water Resources

Southport Mall

P.O. Box 10631

Jackson, Mississippi 39209

WATER WELL DRILLERS LOG

Newton  
H 2011

8-23-83  
date well completed

McDonald & Hill  
firm name

Newton  
county well located

LANDOWNER:	description of formations encountered	from	to
<u>W.J. Cross</u>	<u>clay</u>	<u>0</u>	<u>10</u>
<u>RT # 1 Box 116A Choudry</u> (mailing address)	<u>shale &amp; rock</u>	<u>10</u>	<u>20</u>
<b>WELL LOCATION:</b> sec. <u>34</u> T <u>7</u> N R. <u>13</u> E <u>6</u> miles <u>N</u> of <u>Choudry</u> (distance) (direction) (nearest town)	<u>clay &amp; rock</u>	<u>20</u>	<u>35</u>
	<u>sand</u>	<u>35</u>	<u>59</u>
	<u>rock</u>	<u>59</u>	<u>60</u>
<b>WELL PURPOSE:</b> <u>home</u> (home, irrigation, municipal, industrial)	<u>shale &amp; rock</u>	<u>60</u>	<u>170</u>
<b>WELL COMPLETION DATA:</b>	<u>shale &amp; sand</u>	<u>170</u>	<u>195</u>
(1) diameter (inches) <u>2'</u>	<u>sand</u>	<u>195</u>	<u>205</u>
(2) total depth (feet) <u>205'</u>			
(3) static water level (feet) <u>123'</u> below top of ground.			
(4) casing <u>PVC</u> , <u>200'</u> (material) (depth) <u>2"</u> (size) If telescope see back.			
(5) screen <u>3'</u> , <u>200 to 205</u> (length) (depth to top) <u>2"</u> , <u>PVC</u> (size) (material)			
(6) pump <u>1/2</u> , <u>9</u> (HP) (yield gpm)  (type power)			
(7) electric log _____ (yes or no)  (organization running log)			
(8) how well bottom plugged <u>value</u>			
<b>DRILLERS REMARKS:</b>			


DEPT. OF NATURAL RESOURCES  
BUREAU OF LAND & WATER RESOURCES

AUG 29 1983

RECEIVED

If well telescopes please  
sketch and show depths.

GROUND LEVEL

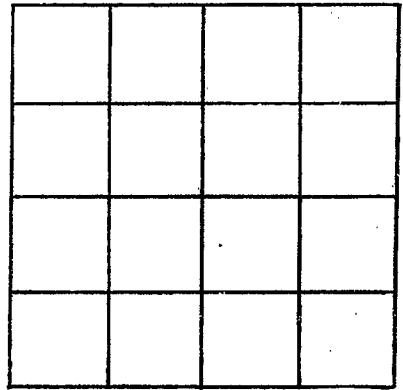

SECTION \_\_\_\_\_

Please indicate well location X.

ADDITIONAL INFORMATION

If more than one screen,  
show locations of each on sketch.