

NEWTON
H 2012

MISSISSIPPI DEPARTMENT OF NATURAL RESOURCES
Bureau of Land and Water Resources
Southport Mall
P.O. Box 10631
Jackson, Mississippi 39209
WATER WELL DRILLERS LOG

7-23-84 19 date well completed
McDonald's Well Newton firm name
county well located

LANDOWNER:	description of formations encountered	from	to
Lindsay Boose	clay st sand	0	30
RT# 1 Box 167-B, Hickman (mailing address)	shale + rock	30	140
WELL LOCATION:	shale st sand	140	150
sec. 32 T 7 N R 13 E 6 miles N of Hickman (distance) (direction) (nearest town)	sand st shale lignite	150	180
WELL PURPOSE: home (home, irrigation, municipal, industrial)	course sand	180	190
WELL COMPLETION DATA:			
(1) diameter (inches) 4 1/2			
(2) total depth (feet) 190'			
(3) static water level (feet) 50' below top of ground.			
(4) casing PVC (material), 147' (depth) 4" (size) if telescope see back.			
(5) screen 10 (length), 180 to 190 (depth to top) 3" (size), PVC (material)			
(6) pump 1 1/2 (HP), 209 gpm (yield/gpm) E (type power)			
(7) electric log (yes or no)			
(organization running log)			
(8) how well bottom plugged value			
DRILLERS REMARKS:			


DEPT. OF NATURAL RESOURCES
BUREAU OF LAND & WATER RESOURCES

JUL 27 1984

RECEIVED

If well telescopes please
sketch and show depths.

GROUND LEVEL

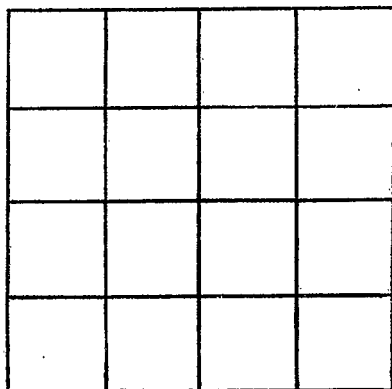

SECTION _____

Please indicate well location X.

ADDITIONAL INFORMATION

If more than one screen,
show locations of each on sketch.