

Newton
H
2013

MISSISSIPPI
BOARD OF WATER COMMISSIONERS
416 North State Street
Jackson, Mississippi 39201

WATER WELL DRILLERS LOG

HAROLD POOLE NEWTON

10/01/84
date well completed

firm name

county well located

LANDOWNER:
ERNEST O. MABRY

RT 2 BOX 73A
LITTLE ROCK, MS.
(mailing address)

WELL LOCATION:
sec. 12 T 7 N R 13 E
S W
10 miles NORTH of CHUNCKY
(distance) (direction) (nearest town)

WELL PURPOSE: HOME
(home, irrigation, municipal, industrial)

WELL COMPLETION DATA:

- (1) diameter (inches) 4"
- (2) total depth (feet) 240'
- (3) static water level (feet) 16' below top of ground.
- (4) casing 4" PVC 156' (material) (depth)
- (size) if telescope see back.
- (5) screen (length) (depth to top)
- (size) (material)
- (6) pump 1/2 hp 12 (HP) (yield gpm)
- 220 (type power)
- (7) electric log (yes or no)
- (organization running log)
- (8) how well bottom plugged OPEN

description of formations encountered	from	to
TOP SOIL light clay	0'	12'
Coarse Sand	12'	14'
Fine Sand	14'	90'
Blue Shell	90'	178'
SAND	178'	240'

DRILLERS REMARKS:
Seemed to be real good water


DEPT. OF NATURAL RESOURCES
BUREAU OF LAND & WATER RESOURCES

OCT 11 1984

RECEIVED

If well telescopes please sketch and show depths.

GROUND LEVEL

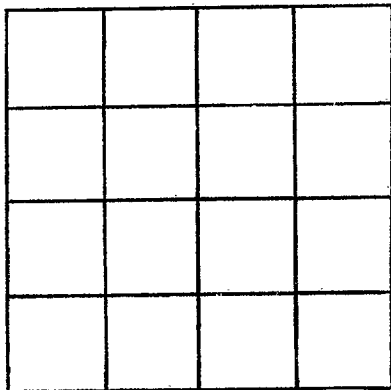

SECTION _____

Please indicate well location X.

ADDITIONAL INFORMATION

If more than one screen,
show locations of each on sketch.