

MISSISSIPPI DEPARTMENT OF NATURAL RESOURCES

Bureau of Land and Water Resources

Southport Mall

P.O. Box 10631

Jackson, Mississippi 39209

WATER WELL DRILLERS LOG

NEWTON
 H 2014
 3-19-85

3-19 1985 McDonald Hill Inc Newton
 date well completed firm name county well located

LANDOWNER: Billy Person

description of formations encountered

from to

R#1 Box 125 B

Clay

0 10

Chunky MS
 (mailing address)

Rock & Shale

10 55

WELL LOCATION:

sec. 7 ^N R. 13 ^E
9 miles North of Chunky
 (distance) (direction) (nearest town)

Sand

55 57

Rock & Shale

57 110

Fine Sand

110 135

Coarse Sand

135 146

WELL PURPOSE: None
 (home, irrigation, municipal, industrial)

WELL COMPLETION DATA:

- (1) diameter (inches) 2
- (2) total depth (feet) 146
- (3) static water level (feet) 86 below above top of ground.
- (4) casing 2" PVC 135'
 (material) (depth)

 if telescope see back.
 (size)

- (5) screen 10' #12
 (length) (depth to top)

2" PVC
 (size) (material)

- (6) pump 10
 (HP) (yield gpm)

 (type power)

- (7) electric log
 (yes or no)

 (organization running log)

- (8) how well bottom plugged 2" back pressure valve

DRILLERS REMARKS:


RECEIVED

MAR 26 1985

Department of Natural Resources
 Bureau of Land & Water Resources

If well telescopes please
sketch and show depths.

GROUND LEVEL

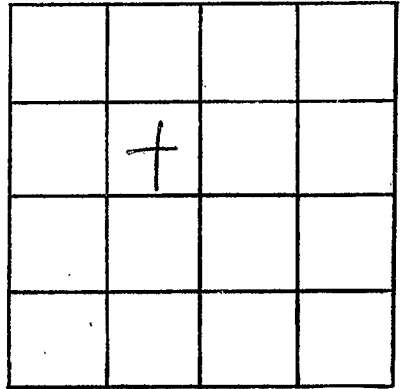

SECTION 76

Please indicate well location X.

ADDITIONAL INFORMATION

If more than one screen,
show locations of each on sketch.