

**MISSISSIPPI
BOARD OF WATER COMMISSIONERS**
416 North State Street
Jackson, Mississippi 39201

WATER WELL DRILLERS LOG

Newton
27
2-68
Elec Log

2/20 1968 Layne-Centel Co. Newton
date well completed firm name county well located

LANDOWNER: Lawrence Water Association,
Lawrence, Miss.
(mailing address)


description of formations encountered	from	to
	<u>Red. Sandy Clay</u>	<u>0</u>
<u>Shale, streaks of sand</u>	<u>70</u>	<u>180</u>
<u>Hard. Shale</u>	<u>180</u>	<u>260</u>
<u>Rock</u>	<u>260</u>	<u>261</u>
<u>Hard. Shale</u>	<u>261</u>	<u>317</u>
<u>Fine sand, streaks of shale</u>	<u>317</u>	<u>335</u>
<u>Gummy Shale</u>	<u>335</u>	<u>360</u>
<u>Sand</u>	<u>360</u>	<u>370</u>
<u>Shale</u>	<u>370</u>	<u>390</u>
<u>Sand, streaks of shale</u>	<u>390</u>	<u>430</u>
<u>Sand</u>	<u>430</u>	<u>497</u>
<u>Shale</u>	<u>497</u>	<u>498</u>

WELL LOCATION: Back of school
sec. 25 T. 60 N. R. 10 E
SE, NE, NW, SW W
(distance) miles (direction) of (nearest town)

WELL PURPOSE: Domestic
(home, irrigation, municipal, industrial)

WELL COMPLETION DATA:

- (1) diameter (inches) 8"
- (2) total depth (feet) 498'
- (3) static water level (feet) 175 below top of ground.
- (4) casing steel, 448',
(material) (depth)
if telescope see back.
(size)
- (5) screen 40', 456'
(length) (depth to top)
1/2", stainless steel
(size) (material)
- (6) pump 20 (HP) (yield gpm)
Electric
(type power)
- (7) electric log yes
(yes or no)
Miss. Geo. Survey
(organization running log)
- (8) how well bottom plugged with
slugs

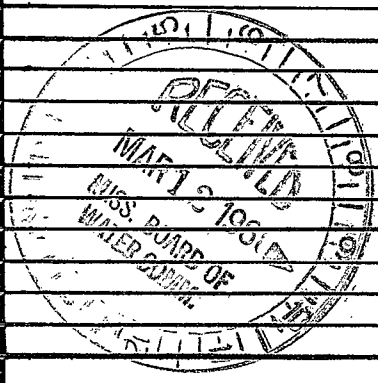

DRILLERS REMARKS:
Pump not installed - no test run as of this date

If well telescopes please sketch and show depths.

GROUND LEVEL

SECTION _____

Please indicate well location X.

ADDITIONAL INFORMATION

If more than one screen,
show locations of each on sketch.