

J3

10-5-61

WATER WELL DRILLERS LOG

Date: 10-5, 1961, Driller: U. L. Kelch county Newton (Name)

(1) Owner of Land: R. L. Stephens (Name)

Lawrence Miss (Address)

(2) Location: SW 1/4, SW 1/4, Sec. 15 T6 R14E

3 miles N.W. of Lawrence (distance) (direction) (Nearest Town)

(3) Topography: (Hilly) (Flat) (Level)

(4) Purpose of Well: Domestic (Domestic Irrigation Municipal, Industrial, Other)

Description & Color of Materials Sand, Clay, Red Clay, Shell, etc.	Thick- ness Feet	Depth Feet
Clay	15	2-15
Shale	60	15-75
Sandy	25	75-100
Sand	20	100-120

Information upon completion of well:

(1) Diameter: 2 inches.

(2) Total Depth: 120 feet.

(3) Water Level: 32 feet below top of ground.

(4) Cased to: 120, Size: 2 1/2"


(5) Screen: Size: 8 slot, Length: 10'

(6) Were any formations sealed against pollution? yes, no. (checked no)

If YES depth of formation

Why

Drillers Remarks:

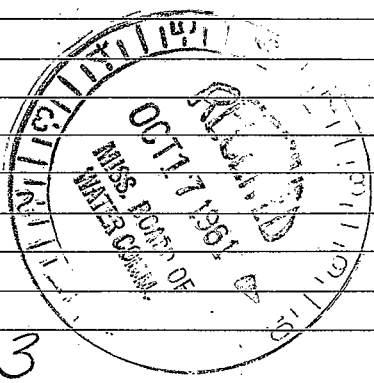

3

23

Well No.

(Use Back Side)

