

WATER WELL DRILLERS LOG

812

Date: 10/31/1961, Driller: Johnnie Beasley County Newton

(Name)

(1) Owner of Land: Alfred Culpepper
(Name)

Rt. #1, Lawrence, Miss.
Turn North on Hwy. 489 and go N 1/2
(Address) to 2nd. right hand road and turn
(2) Location: 1/4, 1/4, Sec. 9 T6 R10E
East for 1 mile, of
(distance) (direction) (Nearest Town)

(3) Topography: x
(Hilly) (Flat) (Level)

(4) Purpose of Well: Domestic
(Domestic Irrigation
Municipal, Industrial, Other)

Description & Color of Materials Sand, Clay, Red Clay, Shell, etc.	Thick- ness Feet	Depth Feet
Red clay.	0-	12
Sand & gravel.	12-	22
Sand. (Screen setting)	22-	68


Information upon completion of well:

- (1) Diameter 2 inches.
- (2) Total Depth 68' feet.
- (3) Water Level 25 feet below top of ground.
- (4) Cased to 63', Size 2"
- (5) Screen: Size 2", Length 5'
- (6) Were any formations sealed against pollution?
no yes, x no.

If YES depth of formation _____

Why _____

Drillers Remarks: Good well.

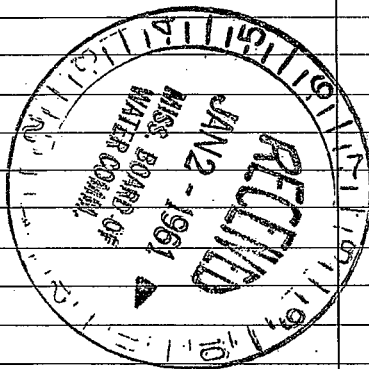

(Use Back Side)

Well No.

